

MISSISSIPPI DEPARTMENT OF NATURAL RESOURCES

Bureau of Land and Water Resources

Southport Mall

P.O. Box 10631

Jackson, Mississippi 39209

WATER WELL DRILLERS LOG

Jackson
N 2193

5-10-83
date well completed

Cross Water Well Serv.
firm name

Jackson
county well located

LANDOWNER: Harry Brackbill
148 24 Parker Road
Biloxi, MS. 39532
(mailing address)

description of formations encountered	from	to
Top soil	0	3'
Red Clay	3	16'
Blue Clay	16'	40'
Red Coarse sand & Gravel	40'	53'
White Clay	53'	86'
Blue Clay	86'	236'
Gray Coarse sand	236'	260'

WELL LOCATION:
sec 2 T 7 N R 9 E
4 miles NW of OCEAN SPRING
(distance) (direction) (nearest town)

WELL PURPOSE: None
(home, irrigation, municipal, industrial)

- WELL COMPLETION DATA:
- (1) diameter (inches) 2"
 - (2) total depth (feet) 260'
 - (3) static water level (feet) 45' below top of ground
 - (4) casing PVC 250' (material) (depth)
2" (size) if telescope see back.
 - (5) screen 10' 250' (length) (depth to top)
2" PVC (size) (material)
 - (6) pump 1 hp. -9- (HP) (yield gpm)
elect. (type power)
 - (7) electric log No. (yes or no)
(organization running log)

(8) how well bottom plugged
Packer and valve

DRILLERS REMARKS:


DEPT. OF NATURAL RESOURCES
BUREAU OF LAND & WATER RESOURCES

JUN 23 1983

RECEIVED

If well telescopes please sketch and show depths.

GROUND LEVEL

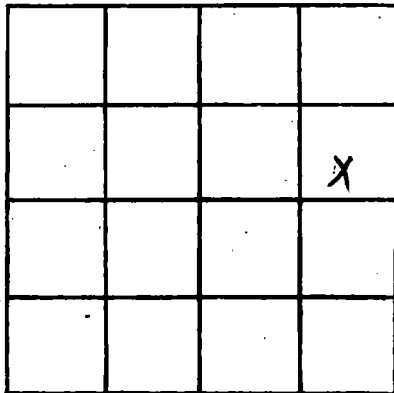

SECTION 2

Please indicate well location X.

ADDITIONAL INFORMATION

If more than one screen,
show locations of each on sketch.