

MISSISSIPPI DEPARTMENT OF NATURAL RESOURCES

Bureau of Land and Water Resources

Southport Mall

P.O. Box 10631

Jackson, Mississippi 39209

WATER WELL DRILLERS LOG

Jackson
N 2198

8-22-83 19 date well completed
Coast Water Well Sew. firm name
Jackson county well located

LANDOWNER	description of formations encountered	from	to
Jack Watts	Top soil	0	2'
102 White Blvd	Red Clay	2'	17'
Ocean Springs, Miss (mailing address) 39564	Red Clay & Wood	17'	21'
	Blue Clay	21'	40'
	Blue Clay & Open Shell	40'	115'
	Gray Coarse sand	115'	162'
	Blue Clay	162'	258'
	Blue Clay & Open Shell	258'	430'
	Blue Clay	430'	494'
	Gray med sand	494'	515'
	Gray Coarse sand	515'	537'
	Blue Clay	537'	547'

WELL LOCATION:

sec. 35 T. 7 N. R. 8 E. of OCEAN SPRINGS
2 miles SE (distance) (direction) (nearest town)

WELL PURPOSE: None
(home, irrigation, municipal, industrial)

WELL COMPLETION DATA:

- (1) diameter (inches) 2"
- (2) total depth (feet) 547'
- (3) static water level (feet) 65' below top of ground
- (4) casing (material) PVC (depth) 537'
- (5) screen (size) 2" (length) 10' (depth to top) 537'
- (6) pump (size) 2" (HP) 2hp (material) PVC (yield gpm) 12
- (7) electric log (type power) elect. (yes or no) No. (organization running log)

(8) how well bottom plugged back wash valve

DRILLERS REMARKS:


DEPT. OF NATURAL RESOURCES
BUREAU OF LAND & WATER RESOURCES

SEP 21 1983

RECEIVED

If well telescopes please sketch and show depths.

GROUND LEVEL

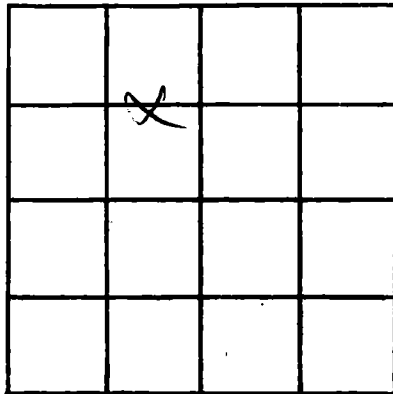

SECTION 35

Please indicate well location X.

ADDITIONAL INFORMATION

If more than one screen, show locations of each on sketch.