

MISSISSIPPI DEPARTMENT OF NATURAL RESOURCES

Bureau of Land and Water Resources

Southport Mall

P.O. Box 10631

Jackson, Mississippi 39209

WATER WELL DRILLERS LOG

Jackson
N2199

10-21-83 date well completed
Coast Water Well Serv. firm name
Jackson county well located

LANDOWNER: W. J. Bond
13508 Goffville Rd.
Ocean Springs, Miss.
(mailing address) 32564

| description of formations encountered | from | to |
|---------------------------------------|------|------|
| Top soil | 0 | 2' |
| Red Clay | 2' | 11' |
| Blue Clay | 11' | 21' |
| Blue Clay & Wood | 21' | 42' |
| White, Coarse sand & gravel | 42' | 65' |
| White Clay | 65' | 86' |
| Blue Clay | 86' | 108' |
| Blue Clay & streak of sand | 108' | 130' |
| Blue Clay | 130' | 183' |
| Blue Clay & clam shell | 183' | 301' |
| Blue Clay & streak of sand | 301' | 325' |
| Gray, Coarse sand | 325' | 366' |
| Blue Clay & clam shell | 366' | 375' |

WELL LOCATION:
sec. 12 T. 7 S. R. 9 E.
2 1/4 miles NW of BEAN SPRING
(distance) (direction) (nearest town)

WELL PURPOSE:
(home, irrigation, municipal, industrial)

WELL COMPLETION DATA:

(1) diameter (inches) 2"

(2) total depth (feet) 375'

(3) static water level (feet) 75' ^{below} top of ground

(4) casing PVC, 365'
(material) (depth)

2" if telescope see back.
(size)

(5) screen 10', 365'
(length) (depth to top)

2", PVC
(size) (material)

(6) pump 1 hp., 6 1/2
(HP) (yield gpm)

check
(type power)

(7) electric log No.
(yes or no)

(organization running log)

(8) how well bottom plugged
back wash valve

DEPT. OF NATURAL RESOURCES
BUREAU OF LAND & WATER RESOURCES


DEC 19 1983

RECEIVED

DRILLERS REMARKS:

If well telescopes please sketch and show depths.

GROUND LEVEL

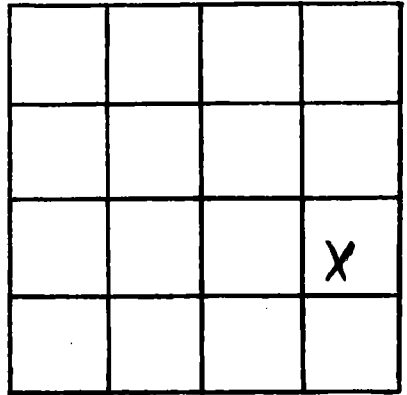

SECTION 12

Please indicate well location X.

ADDITIONAL INFORMATION

If more than one screen, show locations of each on sketch.