

**MISSISSIPPI DEPARTMENT OF NATURAL RESOURCES**  
**Bureau of Land and Water Resources**  
 Southport Mall  
 P.O. Box 10631  
 Jackson, Mississippi 39209  
**WATER WELL DRILLERS LOG**

Jackson  
N 2204

1-13-84 19 1984 Coast Water Well Sew. Jackson  
 date well completed firm name county well located

LANDOWNER: Joseph Covacevich  
P.O. Box 320,  
Clean Springs, Miss  
 (mailing address) 38564

description of formations encountered	from	to
<u>Top soil</u>	<u>0</u>	<u>4'</u>
<u>Red Clay</u>	<u>4'</u>	<u>17"</u>
<u>Blue Clay</u>	<u>17'</u>	<u>48'</u>

WELL LOCATION:  
 sec. 1 T. 7 N. R. 2 W.  
4 miles NW of CLEAN SPRING  
 (distance) (direction) (nearest town)

<u>Gray, coarse sand &amp; gravel</u>	<u>48'</u>	<u>65'</u>
<u>Blue Clay</u>	<u>65'</u>	<u>193'</u>
<u>Blue Clay &amp; streak of sand</u>	<u>193'</u>	<u>220'</u>
<u>Blue Clay</u>	<u>220'</u>	<u>340'</u>

WELL PURPOSE: Home  
 (home, irrigation, municipal, industrial)

WELL COMPLETION DATA:  
 (1) diameter (inches) 2"  
 (2) total depth (feet) 449'  
 (3) static water level (feet) 86' below top of ground.  
 (4) casing PVC 439'  
 (material) (depth)  
2" If telescope see back.  
 (size)  
 (5) screen 10' 439'  
 (length) (depth to top)  
2" PVC  
 (size) (material)  
 (6) pump 3hp 9-  
 (HP) (yield gpm)  
Robert  
 (type power)  
 (7) electric log No.  
 (yes or no)  
 (organization running log)

<u>Blue Clay &amp; streak of sand</u>	<u>193'</u>	<u>220'</u>
<u>Blue Clay</u>	<u>220'</u>	<u>340'</u>
<u>Blue Clay &amp; streak of sand</u>	<u>340'</u>	<u>397'</u>
<u>Gray, coarse sand &amp; wood</u>	<u>397'</u>	<u>442'</u>
<u>Gray, coarse sand &amp; wood</u>	<u>442'</u>	<u>446'</u>
<u>Blue Clay</u>	<u>446'</u>	<u>449'</u>
<u>10'-2" Tail Pipe</u>		

(8) How well bottom plugged Backwash valve

DRILLERS REMARKS:


DEPT. OF NATURAL RESOURCES  
 BUREAU OF LAND & WATER RESOURCES

MAR - 1 1984

**RECEIVED**

If well telescopes please sketch and show depths.

GROUND LEVEL

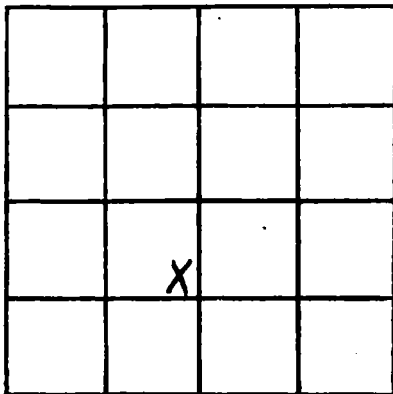

SECTION 1

Please indicate well location X.

ADDITIONAL INFORMATION

If more than one screen, show locations of each on sketch.