

MISSISSIPPI DEPARTMENT OF NATURAL RESOURCES

Bureau of Land and Water Resources

Southport Mall

P.O. Box 10631

Jackson, Mississippi 39209

WATER WELL DRILLERS LOG

Jackson
N3207

2-7-84 19 *Coast Water Well Sew. Jackson*
date well completed firm name county well located

H.A. Contractors
LANDOWNER:

P.O. Box 956
Ocean Springs Miss.
(mailing address) *37564*

description of formations encountered	from	to
<i>Top soil</i>	<i>0</i>	<i>5'</i>
<i>Red Clay</i>	<i>5'</i>	<i>11'</i>
<i>Blue Clay</i>	<i>11'</i>	<i>69'</i>
<i>White Coarse sand</i>	<i>69'</i>	<i>107'</i>
<i>10' Tail Pipe</i>		

WELL LOCATION:
sec. *19* T. *7* N. R. *8* W.
1/2 miles (distance) *N* (direction) of *OCEAN SPRINGS* (nearest town)

WELL PURPOSE: *Home*
(home, irrigation, municipal, industrial)

WELL COMPLETION DATA:

- (1) diameter (inches) *3"*
- (2) total depth (feet) *107'*
- (3) static water level (feet) *18'* below top of ground.
- (4) casing *PVC* (material), *97'* (depth)
2" (size) if telescope see back.
- (5) screen *10'* (length), *97'* (depth to top)
2" (size), *PVC* (material)
- (6) pump (HP) (yield gpm)
- (7) electric log *No.* (yes or no)
(organization running log)
- (8) *back wash valve* (how well bottom plugged)

DEPT. OF NATURAL RESOURCES
BUREAU OF LAND & WATER RESOURCES


APR 30 1984

SPICER WOOD

DRILLERS REMARKS:

If well telescopes please sketch and show depths.

GROUND LEVEL

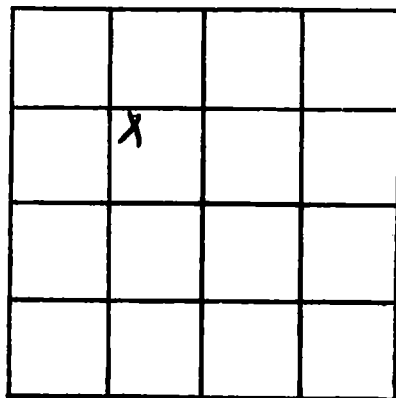

SECTION 29

Please indicate well location X.

ADDITIONAL INFORMATION

If more than one screen, show locations of on sketch.