

MISSISSIPPI DEPARTMENT OF NATURAL RESOURCES

Bureau of Land and Water Resources

Southport Mall

P.O. Box 10631

Jackson, Mississippi 39209

WATER WELL DRILLERS LOG

Jackson
N 2208

5/11/84
date well completed

Mc Hill Well Works
firm name

Jackson
county well located

LANDOWNER: William Vaughn
11817 Seaman Rd
Ocean Springs, Ms.
(mailing address)

description of formations encountered	from	to
Mud	0	100
Sand & mud	100	130
Mud	130	200
Sand & mud	200	230
Mud	230	280
Sand & mud	280	300
Mud	300	440
Sand & mud	440	460
Sand	460	480

WELL LOCATION:
sec. 17 T 1 N R 8 E
4 miles W of D.S.
(distance) (direction) (nearest town)

WELL PURPOSE: Home
(home, irrigation, municipal, industrial)

WELL COMPLETION DATA:

- (1) diameter (inches) 9"
- (2) total depth (feet) 480'
- (3) static water level (feet) 60' below top of ground.
- (4) casing 4" sch 40 pipe 400' (material), (depth)
- (size) if telescope see back.
- (5) screen 10' 400' (length), (depth to top)
- 2" sch 80 (size), (material)
- (6) pump 1 (HP) 10 (yield gpm)
- elec. (type power)
- (7) electric log (yes or no)
- (organization running log)

(8) how well bottom plugged Sand Seal

DRILLERS REMARKS:


DEPT. OF NATURAL RESOURCES
BUREAU OF LAND & WATER RESOURCES

JUN - 1 1984

RECEIVED

If well telescopes please sketch and show depths.

GROUND LEVEL

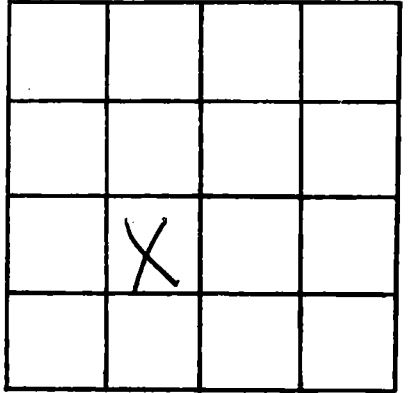

SECTION _____

Please indicate well location X.

ADDITIONAL INFORMATION

Multiple horizontal lines for writing additional information.

If more than one screen, show locations of each on sketch.