

MISSISSIPPI DEPARTMENT OF NATURAL RESOURCES

Bureau of Land and Water Resources

Southport Mall

P.O. Box 10631

Jackson, Mississippi 39209

WATER WELL DRILLERS LOG

Jackson  
N 2209

4-11-84 19 McNeil Well Works Inc Jackson  
date well completed firm name county well located

LANDOWNER: Maxine Claxee  
Rt. 3 Box 36E  
Ocean Springs, MS  
(mailing address) 39564

WELL LOCATION:  
sec. 7 T 7 N R 8 E  
5 miles W of Ocean Spn  
(distance) (direction) (nearest town)

WELL PURPOSE:  
(home, irrigation, municipal, industrial)

WELL COMPLETION DATA:  
(1) diameter (inches) 2"  
(2) total depth (feet) 740'  
(3) static water level (feet) 730' (below above top of ground)  
(4) casing (material) PVC (depth) 730'  
(size) If telescope see back.  
(5) screen (length) 10' (depth to top) 730'  
(size) 2" (material) PVC  
(6) pump (HP) 1/2 (yield gpm) 6  
(type power) elec.  
(7) electric log (yes or no)  
(organization running log)  
(8) how well bottom plugged sand Seal

description of formations encountered	from	to
Mud	0	160
Sand & Mud	160	180
Mud	180	260
Muds Sand	260	380
Mud	380	380
Sand & Mud	380	400
Mud	400	600
Muds Sand	600	620
Mud	620	680
Muds Sand	680	700
Sand	700	740

DEPT. OF NATURAL RESOURCES  
BUREAU OF LAND & WATER REBOURCE


JUN - 1 1984

RECEIVED

DRILLERS REMARKS:

If well telescopes please sketch and show depths.

GROUND LEVEL

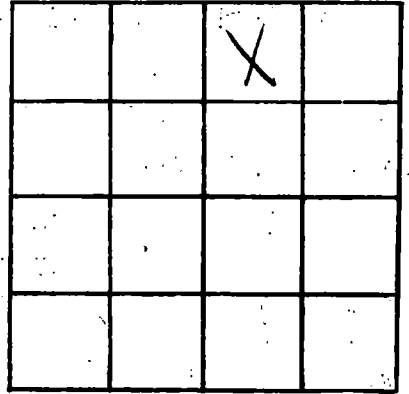

SECTION \_\_\_\_\_

Please indicate well location X.

**ADDITIONAL INFORMATION**

If more than one screen, show locations of each on sketch.