

MISSISSIPPI DEPARTMENT OF NATURAL RESOURCES

Bureau of Land and Water Resources

Southport Mall

P.O. Box 10631

Jackson, Mississippi 39209

WATER WELL DRILLERS LOG

COASTAL DRILLING & SERVICE CO.

Jackson
N 2211

9/10/83 19
date well completed

ROUTE 1 BOX 518

Jackson
county well located

LANDOWNER

Anna Seymour

description of formations encountered

from

to

Jatune City
Biloxi, MS
(mailing address)

<i>top soil</i>	1	3
<i>Red Clay</i>	3	15
<i>gray silt</i>	15	30
<i>light blue clay</i>	30	210
<i>hard blue clay</i>	210	250
<i>soft water sand</i>	250	270

WELL LOCATION:

sec. 14 T. 2 N R. 9 E
5 1/2 miles (distance) *S* (direction) *Jatune City* (nearest town)

WELL PURPOSE:

(home, irrigation, municipal, industrial) *home*

WELL COMPLETION DATA:

- (1) diameter (Inches) 2"
- (2) total depth (feet) 270'
- (3) static water level (feet) 35' below top of ground.
- (4) casing PK 260'
(material) (depth)
(size) if telescope see back.
- (5) screen 10' 260'
(length) (depth to top)
2" PK
(size) (material)
- (6) pump None 12
(HP) (yield gpm)
3hp
(type power)
- (7) electric log no
(yes or no)

(organization running log)

(8) how well bottom plugged

2" sandstone
DRILLERS REMARKS: *19-18*


DEPT. OF NATURAL RESOURCES
BUREAU OF LAND & WATER RESOURCES

JUN 28 1984

RECEIVED

If well telescopes please sketch and show depths.

GROUND LEVEL

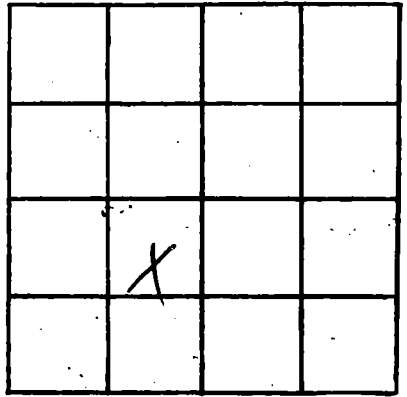

SECTION _____

Please indicate well location X.

ADDITIONAL INFORMATION

If more than one screen, show locations of each on sketch.