

MISSISSIPPI DEPARTMENT OF NATURAL RESOURCES

Bureau of Land and Water Resources

Southport Mall

P.O. Box 10631

Jackson, Mississippi 39209

WATER WELL DRILLERS LOG  
COASTAL DRILLING & SERVICE CO.

ROUTE 1 BOX 618

firm name  
BILOXI, MISS. 39532

county well located

Jackson  
N 2A2

10/12/83 19  
date well completed

LANDOWNER  
Raymond Lewis

P.O. # 596

Clear Spring Mrs  
(mailing address)

description of formations encountered	from	to
Top Soil	1	3
Red Clay	3	10
Sandy Sand	10	25
Blue Clay	25	20
Base White Sand	20	95

WELL LOCATION:

sec 30 T 2 N R 8 E  
Back on Clear Spring  
(distance) miles (direction) of (nearest town)

WELL PURPOSE:  
(home, irrigation, dual, industrial)  
Home Water Pump

WELL COMPLETION DATA:

- (1) diameter (inches) 4"
- (2) total depth (feet) 95'
- (3) static water level (feet) 0' top of ground.
- (4) casing (material) PVC (depth) 95'
- 4 1/2" (size) if telescope see back.
- (5) screen 10' (length) 85' (depth to top)  
2" (size) PVC (material)
- (6) pump 1/2 HP (HP) 15 (yield gpm)  
5 hp (type power)
- (7) electric log No (yes or no)

(organization running log)

(8) how well bottom plugged  
2' back with blue

DRILLERS REMARKS: 19-B


DEPT. OF NATURAL RESOURCES  
BUREAU OF LAND & WATER RESOURCES

JUL - 2 1984

RECEIVED

If well telescopes please sketch and show depths.

GROUND LEVEL

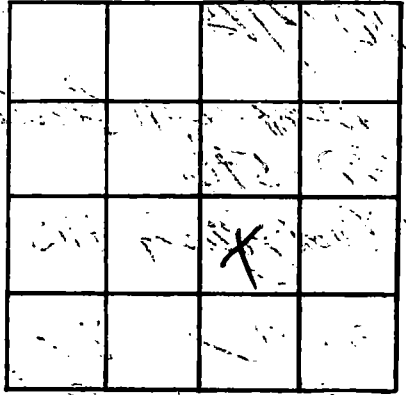

SECTION \_\_\_\_\_

Please indicate well location X.

ADDITIONAL INFORMATION

If more than one screen, show locations of each on sketch.