

MISSISSIPPI DEPARTMENT OF NATURAL RESOURCES

Bureau of Land and Water Resources

Southport Mall

P.O. Box 10631

Jackson, Mississippi 39209

WATER WELL DRILLERS LOG

JACKSON  
N 2215

#-30-84 19 date well completed  
Coast & Water Well Sew. Jackson firm name  
county well located

LANDOWNER:

description of formations encountered

from

to

Thomas Canale

Top soil

0

3'

13713 Shearale Rd.

Red Clay

3' 14'

Ocean Springs, Miss.  
(mailing address) 39164

Blue Clay

14' 44'

WELL LOCATION:

gray coarse sand & wood

44' 56'

sec. L T 7 R 9  
4 miles NW of Ocean Springs  
(distance) (direction) (nearest town)

WELL PURPOSE:

(home, irrigation, municipal, industrial)

Home

Blue Clay

56' 325'

WELL COMPLETION DATA:

gray coarse sand

325' 349'

(1) diameter (inches) 2"

Blue Clay

349' 356'

(2) total depth (feet) 359'

(3) static water level (feet) 90' (below above top of ground)

Blue fine sand

356' 359'

(4) casing PVC 349'  
(material) (depth)

10' x 2" Tail Pipe

(5) screen 2" 349'  
(length) (depth to top)

(6) pump 2 HP 8  
(HP) (yield gpm)

(7) electric log No.  
(yes or no)

(8) how well bottom plugged  
check valve

(organization running log)

(8) how well bottom plugged  
check valve

DRILLERS REMARKS:


DEPT. OF NATURAL RESOURCES  
BUREAU OF LAND & WATER RESOURCES

JUL 10 1984

RECEIVED

If well telescopes please sketch and show depths.

GROUND LEVEL

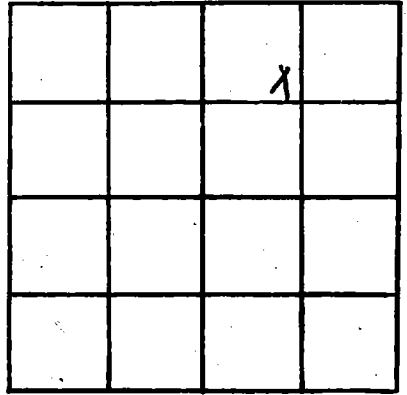

SECTION   C  

Please indicate well location X.

ADDITIONAL INFORMATION

A series of 20 horizontal lines for recording additional information.

If more than one screen, show locations of each on sketch.