

MISSISSIPPI DEPARTMENT OF NATURAL RESOURCES

Bureau of Land and Water Resources

Southport Mall

P.O. Box 10631

Jackson, Mississippi 39209

WATER WELL DRILLER'S LOG

N 2221
JACKSON
1-3-85

1/3/85 date well completed

Fryfogel Well Co. firm name
Jackson county well located

LANDOWNER: H. L. Hurley
1008 Lake Ave.
Vandeventer MS
(mailing address)

WELL LOCATION:
sec. 18 T 7 R 8 E
2 miles (distance) N.W. (direction) of Ocean Springs (nearest town)
on Highway 175

WELL PURPOSE:
(home, irrigation, municipal, industrial)

WELL COMPLETION DATA:
(1) diameter (inches) 2"
(2) total depth (feet) 385'
(3) static water level (feet) 60' below top of ground.
(4) casing PVC 380 (material) (depth)
3" (size) If telescope see back.
(5) screen 5' 380' (length) (depth to top)
2" (size) PVC (material)
(6) pump 1 (HP) 10 (yield gpm)
Slut (type power)
(7) electric log no (yes or no)
(organization running log)
(8) how well bottom plugged PVC Ballhead

description of formations encountered	from	to
Top Soil & S&S	0	20
Clay (Brown)	20	40
Shaly med. clay	40	60
Clay	60	80
Clay	80	100
Clay	100	120
Fine Sand	120	160
Clay	160	180
Clay	180	200
Clay	200	220
Clay	220	240
Clay	240	320
Cyp Log Clay	320	322
Clay	322	340
Clay	340	351
Fine Sand	351	370
Coarse sand	370	385


RECEIVED
FEB 8 1985

Department of Natural Resources
Bureau of Land & Water Resources

DRILLERS REMARKS:

If well telescopes please sketch and show depths.

GROUND LEVEL

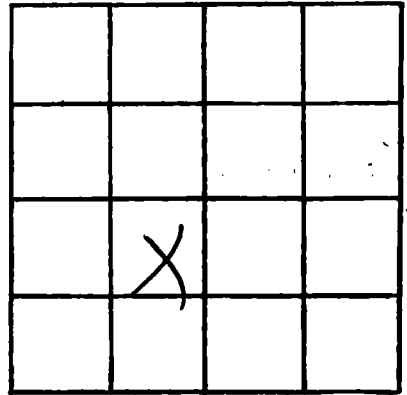

SECTION 13

Please indicate well location X.

ADDITIONAL INFORMATION

If more than one screen, show locations of each on sketch.