

MISSISSIPPI DEPARTMENT OF NATURAL RESOURCES

Bureau of Land and Water Resources

Southport Mall

P.O. Box 10631

Jackson, Mississippi 39209

WATER WELL DRILLERS LOG

Jackson
N 2222

10-10-84
date well completed

Cross Water Well Sew. Jackson
firm name county well located

LANDOWNER: J. Spell
6212 Old Fort Bayou Rd
Ocean Springs, Miss.
(mailing address) 39564

description of formations encountered	from	to
Sandy Top soil	0	12'
Gravelly Clay	12'	37'
Coarse sand	37'	53'
Blue Clay	53'	74'
Coarse sand	74'	95'
Blue Clay	95'	110'
Coarse sand	110'	180'

WELL LOCATION:
sec 8 T 7 N R 8 E
2 miles N of OCEAN SPRINGS
(distance) (direction) (nearest town)

WELL PURPOSE: Home
(home, irrigation, municipal, industrial)

WELL COMPLETION DATA:
(1) diameter (inches) 2"
(2) total depth (feet) 180'
(3) static water level (feet) 15' ^{below} _{above} top of ground
(4) casing PVC, 170' (material), (depth)
2" (size) if telescope see back,
(5) screen 10' (length), 170' (depth to top)
2" (size), PVC (material)
(6) pump 1 h.p. (HP), 12 (yield gpm)
Electric (type power)
(7) electric log No (yes or no)
(organization running log)

5/8" x 2" Vial Pipe


(8) how well bottom plugged
Crack Wash Valve

DRILLERS REMARKS:

1-8-85
JFW

If well telescopes please sketch and show depths.

GROUND LEVEL

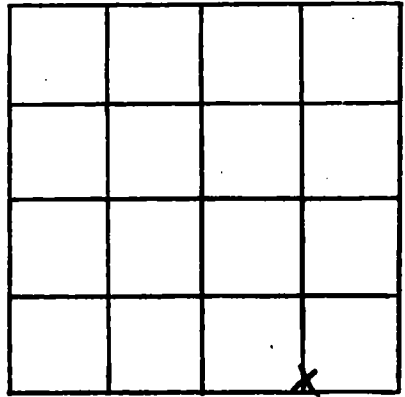

SECTION 8

Please indicate well location X.

ADDITIONAL INFORMATION

If more than one screen, show locations of each on sketch.