

MISSISSIPPI DEPARTMENT OF NATURAL RESOURCES
 Bureau of Land and Water Resources
 Southport Mall
 P.O. Box 10631

Jackson, Mississippi 39209
WATER WELL DRILLERS LOG

Jackson
 N 2224

1-5-84 1984 Coastal Water Well Serv. Jackson
 date well completed firm name county well located

LANDOWNER: Richard Paulson
Box 318 F,
Biloxi, miss.
 (mailing address) 39132

WELL LOCATION:
 sec. 3 T. 7 N R. 9 E
2 miles N of IBERVILLE
 (distance) (direction) (nearest town)

WELL PURPOSE: Home
 (home, irrigation, municipal, industrial)

- WELL COMPLETION DATA:
- (1) diameter (Inches) 2"
 - (2) total depth (feet) 435'
 - (3) static water level (feet) 72' below above top of ground.
 - (4) casing PVC 425'
 (material) (depth)
2" if telescope see back.
 (size)
 - (5) screen 10' 425'
 (length) (depth to top)
2" PVC
 (size) (material)
 - (6) pump 1/2 hp 6
 (HP) (yield gpm)
Elect.
 (type power)
 - (7) electric log No.
 (yes or no)
—
 (organization running log)
 - (8) How well bottom plugged back wash blue


description of formations encountered	from	to
<u>Top soil</u>	<u>0</u>	<u>3'</u>
<u>Red Clay</u>	<u>3'</u>	<u>18"</u>
<u>Blue Clay</u>	<u>18"</u>	<u>232'</u>
<u>Fine Med Sand</u>	<u>232'</u>	<u>249'</u>
<u>Blue Clay</u>	<u>249'</u>	<u>387'</u>
<u>Coarse sand</u>	<u>387'</u>	<u>435'</u>

f-8-85
 y r w

DRILLERS REMARKS:

If well telescopes please sketch and show depths.

GROUND LEVEL

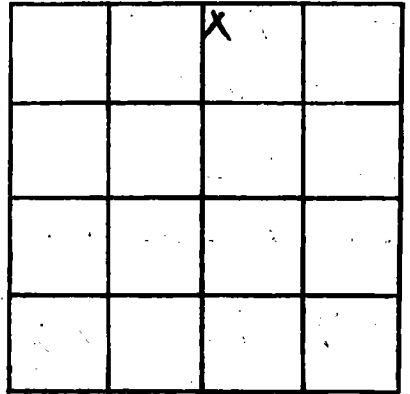

SECTION 3

Please indicate well location X.

ADDITIONAL INFORMATION

If more than one screen, show locations of each on sketch.