

MISSISSIPPI DEPARTMENT OF NATURAL RESOURCES

Bureau of Land and Water Resources

Southport Mall

P.O. Box 10631

Jackson, Mississippi 39209

WATER WELL DRILLERS LOG

COASTAL DRILLING & SERVICE CO.

JACKSON

JACKSON  
N 9281  
5/16/85

5/16/85  
date well completed

RT# 11, BOX 81

firm name

county well located

BILOXI, MS 39532

LANDOWNER: MAL HANSDON

description of formations encountered	depth	
	from	to
top soil	1	5
sea sand	5	20
red clay	20	160
fine water sand	160	170
poor water sand	170	180

2055 Juniper Lane

BILOXI, MS  
(mailing address)

WELL LOCATION:

sec. 24 T. 2 N R. 9 W

0.1 miles (distance) S (direction) of Biloxi (nearest town)

WELL PURPOSE: home  
(home, irrigation, municipal, industrial)

WELL COMPLETION DATA:

(1) diameter (inches) 2"

(2) total depth (feet) 180

(3) static water level (feet) 10 below top of ground

(4) casing PVC, 170 (material) (depth)

(size) If telescope see back.

(5) screen 10', 170 (length) (depth to top)

3" PVC (size) (material)

(6) pump 1, 9 (HP) (yield gpm)

ELC (type power)

(7) electric log NO (yes or no)

(organization running log)

(8) how well bottom plugged 2" back wash water 19-B

DRILLERS REMARKS:


RECEIVED

MAY 27 1985

Department of Natural Resources  
Bureau of Land and Water Resources

If well telescopes please sketch and show depths.

GROUND LEVEL

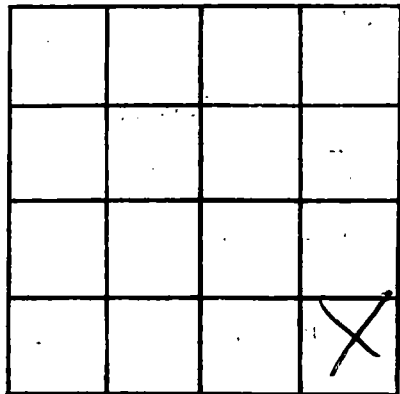

SECTION \_\_\_\_\_

Please indicate well location X.

ADDITIONAL INFORMATION

If more than one screen,  
show locations of each on sketch.