

MISSISSIPPI DEPARTMENT OF NATURAL RESOURCES

Bureau of Land and Water Resources

Southport Mall

P.O. Box 10631

Jackson, Mississippi 39209

COASTAL DRILLING WATER WELL DRILLERS LOG & SERVICE CO.

RT. 11, BOX 31

Jackson

BILOXI, MS 39532

firm name

county well located

JACKSON
N 2233
4/27/85

4/27/85
date well completed

LANDOWNER: T.W. BARNETT

description of formations encountered

from to

Brown Rd

top soil

1 10

Ocean Springs
(mailing address)

lagoon sand

10 25

red clay

25 210

light blue clay

210 300

hard blue clay

300 400

artesian sand

400 410

artesian sand

410 420

WELL LOCATION:

sec. 30 T 7 S R 8 E
Ocean Springs
(distance) (direction) (nearest town)

WELL PURPOSE: Home
(home, irrigation, municipal, industrial)

WELL COMPLETION DATA:

(1) diameter (inches) 4" x 2"
(2) total depth (feet) 420
(3) static water level (feet) 15 (below/above top of ground)

(4) casing PVC, 405
(material) (depth)
(size) If telescope see back.

(5) screen 15, 405
(length) (depth to top)
2' PVC
(size) (material)

(6) pump 1, 10
(HP) (yield gpm)
Etc
(type power)

(7) electric log No
(yes or no)
(organization running log)

(8) how well bottom plugged 2" back
wash ball 1A-B

DRILLERS REMARKS:

RECEIVED
AUG 27 1985

Department of Natural Resources
Bureau of Land & Water Resources

If well telescopes please sketch and show depths.


GROUND LEVEL

160' 4" PVC
casing

260' 2" PVC
casing

15' 2" PVC
screen

2' back wash
valve

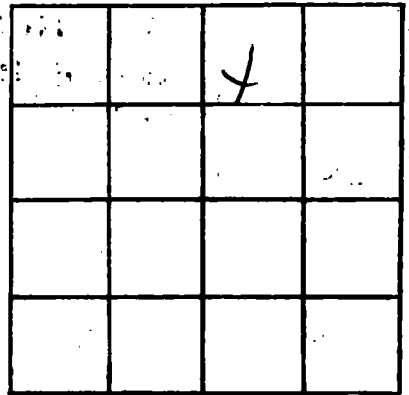

SECTION _____

Please indicate well location X.

ADDITIONAL INFORMATION

If more than one screen,
show locations of each on sketch.