

MISSISSIPPI DEPARTMENT OF NATURAL RESOURCES

Bureau of Land and Water Resources

Southport Mall

P.O. Box 10631

Jackson, Mississippi 39209

WATER WELL DRILLERS LOG

COASTAL DRILLING & SERVICE CO.

JACKSON  
N 2937  
  
11/4/85

date well completed 19 85 NOV. 11, LAUREL MISS. county well located JACKSON

LANDOWNER: Doug Clark  
1208 Sammy Rd  
Ocean Springs, MS  
(mailing address)

WELL LOCATION:  
sec. 29 T. 2 R. 8  
Ocean Springs  
(distance) (direction) (nearest town)

WELL PURPOSE: HOME  
(home, irrigation, municipal, industrial)

WELL COMPLETION DATA:  
(1) diameter (inches) 2"  
(2) total depth (feet) 410  
(3) static water level (feet) 10 below above top of ground.  
(4) casing PVC, 400  
(material) (depth)  
(size) If telescope see back.  
(5) screen 10, 400  
(length) (depth to top)  
2", PVC  
(size) (material)  
(6) pump 1, 169  
(HP) (yield gpm)  
etc.  
(type power)  
(7) electric log NO  
(yes or no)  
(organization running log)  
(8) how well bottom plugged 2" back  
washed 19-B

description of formations encountered	from	to
top soil	1	10
seign sand	10	20
red clay	20	190
course white sand	190	230
hard blue clay	230	380
runwater sand	380	400
good water sand	400	410


RECEIVED

AUG - 5 1985

DRILLERS REMARKS: Department of Natural Resources  
Bureau of Land & Water Resources

If well telescopes please sketch and show depths.

GROUND LEVEL

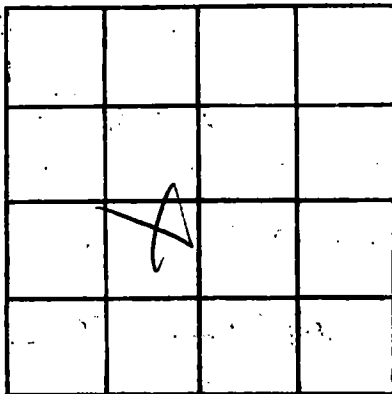

SECTION \_\_\_\_\_

Please indicate well location X.

ADDITIONAL INFORMATION

If more than one screen, show locations of each on sketch.