

MISSISSIPPI DEPARTMENT OF NATURAL RESOURCES

Bureau of Land and Water Resources

Southport Mall

P.O. Box 10631

Jackson, Mississippi 39209

WATER WELL DRILLERS LOG

JACKSON  
N 7239

3-19-85 date well completed 85' Coast Water Well Sew. firm name Jackson county well located

LANDOWNER: Paul White  
15404 Desmoke Dr.  
North Biloxi Miss.  
(mailing address)

WELL LOCATION:  
sec. 15 T. 7 N. R. 9 E.  
1N miles (distance) (direction) of St. Martin (nearest town)

WELL PURPOSE: Home  
(home, irrigation, municipal, industrial)

WELL COMPLETION DATA:

(1) diameter (inches) 2"

(2) total depth (feet) 225'

(3) static water level (feet) 46' <sup>below</sup> top of ground

(4) casing PVC, 2 1/2" (material) (depth)

2" (size) If telescope see back.

(5) screen 10', 2 1/2" (length) (depth to top)

2" (size) PVC (material)

(6) pump \_\_\_\_\_ (HP) \_\_\_\_\_ (yield gpm)

Sheet (type power)

(7) electric log No (yes or no)

\_\_\_\_\_ (organization running log)

(8) how well bottom plugged Back Wash Valve

description of formations encountered	from	to
Top soil	0'	5'
Red Clay	5'	8'
White Coarse sand	8'	20'
Blue Clay & streak of sand	20'	43'
Blue Clay	43'	70'
Blue Clay - streak of sand	70'	100'
Blue Clay	100'	149'
Blue Mud Sand	149'	157'
Blue Clay	157'	209'
Gray Coarse sand	209'	221'
Blue Clay	221'	225'


RECORDED  
JUL 10 1985

Department of Natural Resources  
Bureau of Land & Water Resources

DRILLERS REMARKS:

If well telescopes please sketch and show depths.

GROUND LEVEL

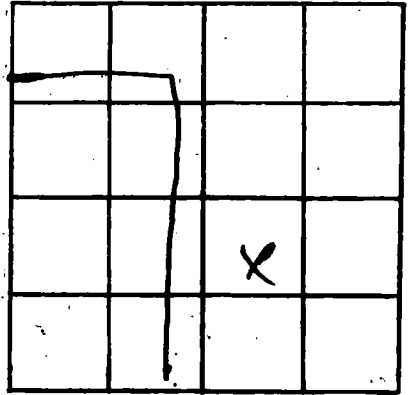

SECTION 15

Please indicate well location X.

**ADDITIONAL INFORMATION**

Lined area for additional information.

If more than one screen, show locations of each on sketch.