

MISSISSIPPI DEPARTMENT OF NATURAL RESOURCES

Bureau of Land and Water Resources

Southport Mall

P.O. Box 10631

Jackson, Mississippi 39209

WATER WELL DRILLERS LOG

JACKSON
N 2242

4-5-85 date well completed 19 Coast Water Well Sew. firm name Jackson county well located

LANDOWNER: Jerry Jarrell
158 W. Lee Patch Rd.
Bidlohus, Miss.
(mailing address) 39532

WELL LOCATION:
sec 3 T 7 N R 9
2 miles N of DIBERVILLE
(distance) (direction) (nearest town)

WELL PURPOSE: Home
(home, irrigation, municipal, industrial)

WELL COMPLETION DATA:

- (1) diameter (inches) 2"
- (2) total depth (feet) 430'
- (3) static water level (feet) 65' (below above top of ground.)
- (4) casing PVC 410'
(material) (depth)
- 2"
(size) if telescope see back.
- (5) screen 20' 410'
(length) (depth to top)
- 2" PVC
(size) (material)
- (6) pump 1 h.p. 8
(HP) (yield gpm)
- Elec.
(type power)
- (7) electric log No
(yes or no)
- (organization running log)
- (8) how well bottom plugged Lock Wash Valve

| description of formations encountered | from | to |
|---------------------------------------|-------------|-------------|
| <u>Top soil</u> | <u>0</u> | <u>2'</u> |
| <u>Red Clay</u> | <u>2</u> | <u>18'</u> |
| <u>Sand white coarse</u> | <u>18'</u> | <u>40'</u> |
| <u>Sand & Clay gray</u> | <u>75'</u> | <u>215'</u> |
| <u>Blue Clay & Sand</u> | <u>215'</u> | <u>301'</u> |
| <u>Blue Clay & Shell</u> | <u>301'</u> | <u>322'</u> |
| <u>Blue Clay</u> | <u>322'</u> | <u>385'</u> |
| <u>Med. Sand</u> | <u>385'</u> | <u>405'</u> |
| <u>Coarse Pigeon sand</u> | <u>405'</u> | <u>430'</u> |


RECEIVED
JUL 10 1985

DRILLERS REMARKS:

Department of Natural Resources
Bureau of Land & Water Resources

If well telescopes please sketch and show depths.

GROUND LEVEL

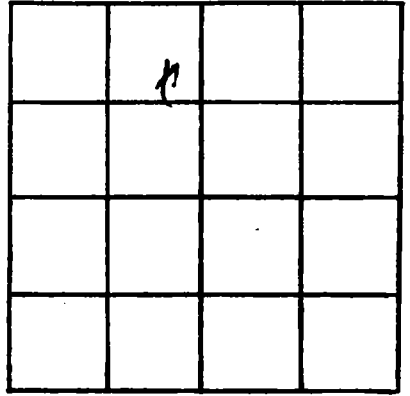

SECTION 3

Please indicate well location X.

ADDITIONAL INFORMATION

If more than one screen,
show locations of each on sketch.