

MISSISSIPPI DEPARTMENT OF NATURAL RESOURCES

Bureau of Land and Water Resources

Southport Mall

P.O. Box 10631

Jackson, Mississippi 39209

WATER WELL DRILLERS LOG

COASTAL DRILLING & SERVICE CO.

Jackson
N 2243
5-26-84

L

5/26/84
date well completed

ROUTE 1 BOX 618
firm name

JACKSON

county well located

BILOXI, MISS. 39532

LANDOWNER: John D. Opurac

Jim Roney Rd.

Ocean Springs, Miss
(mailing address)

description of formations encountered

from to

top soil	1	3
red clay	3	20
course white sand	20	90
sugar sand	90	120
soft blue clay	120	320
fine sand shell	320	400
good water sand	400	410

WELL LOCATION:

sec. 21 T. 7 S. R. 8 W.

Ocean Springs

(distance) (direction) (nearest town)

WELL PURPOSE: home
(home, irrigation, municipal, industrial)

WELL COMPLETION DATA:

- (1) diameter (inches) 2"
- (2) total depth (feet) 410
- (3) static water level (feet) 25 below top of ground
- (4) casing PVC, 400 (material), (depth)
- (size) if telescope see back.
- (5) screen 10' (length), 400 (depth to top)
- 2" (size), PVC (material)
- (6) pump 1/2 (HP), 729 (yield gpm)
- ELC (type power)
- (7) electric log NO (yes or no)

(organization running log)

(8) how well bottom plugged
2" BACKWASH CLAUDE


DRILLERS REMARKS: 19-B
NONE

RECEIVED
JUL 22 1985

Department of Natural Resources
Bureau of Land & Water Resources

If well telescopes please sketch and show depths.

GROUND LEVEL

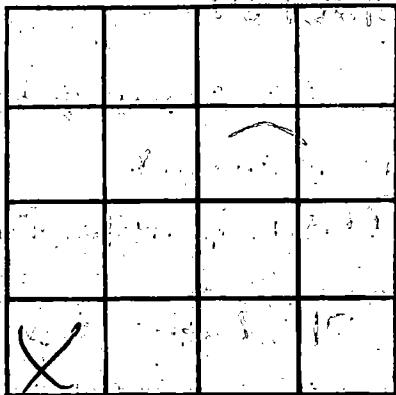

SECTION _____

Please indicate well location X.

ADDITIONAL INFORMATION

If more than one screen, show locations of each on sketch.