

MISSISSIPPI DEPARTMENT OF NATURAL RESOURCES

Bureau of Land and Water Resources

Southport Mall

P.O. Box 10631

Jackson, Mississippi 39209

WATER WELL DRILLERS LOG

Jackson
N 2245
6-5-85

6-5-85 date well completed
Coast Water Well Sew. firm name
Jackson county well located

LANDOWNER: George Smith
Rt 3 Box 254A.
Biloxi, Miss.
(mailing address) 39532

WELL LOCATION:
sec. 12 T. 2 N. R. 9 E.
3 3 NW DEAN SPRINGS
(distance) miles (direction) (nearest town)

WELL PURPOSE: None
(home, irrigation, municipal, industrial)

WELL COMPLETION DATA:
(1) diameter (inches) 2"
(2) total depth (feet) 431'
(3) static water level (feet) 95' below top of ground.
(4) casing PVC 411' (material) (depth)
2" (size) if telescope see back.
(5) screen 20' 411' (length) (depth to top)
2" PVC (size) (material)
(6) pump 2 hp. 12 (HP) (yield gpm)
Electric (type power)
(7) electric log No (yes or no)
(organization running log)
(8) how well bottom plugged Back wash valve

description of formations encountered	from	to
Top soil	0	2'
Gray Clay	2'	40'
Coarse white sand	40'	65'
Blue Clay	65'	110'
Coarse white sand	110'	165'
Blue Clay	165'	255'
Blue Clay (chip sand)	255'	340'
Med. Gray sand	340'	345'
Blue Clay (chip sand)	345'	385'
Coarse sand (Lignum)	385'	431'


RECEIVED
JUL 11 1985

Department of Natural Resources
Bureau of Land & Water Resources

DRILLERS REMARKS:

If well telescopes please sketch and show depths.

GROUND LEVEL

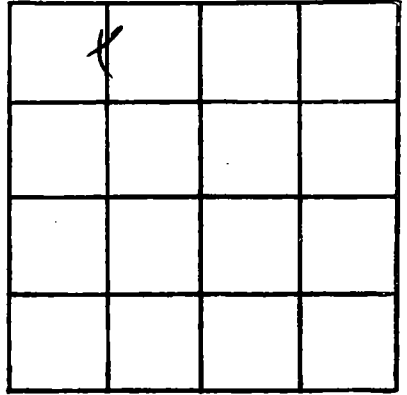

SECTION 12

Please indicate well location X.

ADDITIONAL INFORMATION

If more than one screen,
show locations of each on sketch.