

MISSISSIPPI DEPARTMENT OF NATURAL RESOURCES

Bureau of Land and Water Resources

Southport Mall

P.O. Box 10631

Jackson, Mississippi 39209

WATER WELL DRILLERS LOG

Jackson
N 2247
6-3-85

6-3-85

Coast Water Well Sew.

Jackson

date well completed

firm name

county well located

LANDOWNER:

11505 Wilfred Church Rd.

Ocean Springs, Miss.
(mailing address)

WELL LOCATION:

sec. 8 T 7 N R 8 E
2 miles N of OCEAN SPRINGS
(distance) (direction) (nearest town)

WELL PURPOSE:

(home, irrigation, municipal, industrial)

WELL COMPLETION DATA:

- (1) diameter (inches) 3"
- (2) total depth (feet) 180'
- (3) static water level (feet) 24' below top of ground.
- (4) casing PVC (material), 170' (depth)
2" (size) if telescope see back.
- (5) screen 10' (length), 170' (depth to top)
2" (size), PVC (material)
- (6) pump 1 hp. (HP), 11 (yield gpm)
Elect. (type power)
- (7) electric log No (yes or no)

(organization running log)

(8) how well bottom plugged
Back wash valve

Description of formations encountered

from to

Top soil	0	3'
Red Clay	3'	7'
Blue Clay	7'	15'
White coarse sand	15'	40'
Blue Clay	40'	105'
Blue Clay & streak of sand	105'	135'
Gray coarse sand	135'	180'
5'-2" PVC tile pipe		

RECEIVED


JUL 11 1985

DRILLERS REMARKS:

Department of Natural Resources
Bureau of Land & Water Resources

If well telescopes please sketch and show depths.

GROUND LEVEL

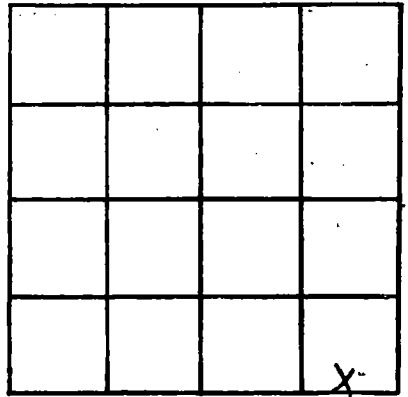

SECTION 8

Please indicate well location X.

ADDITIONAL INFORMATION

If more than one screen,
show locations of each on sketch.