

MISSISSIPPI DEPARTMENT OF NATURAL RESOURCES

Bureau of Land and Water Resources

Southport Mall

P.O. Box 10631

Jackson, Mississippi 39209

WATER WELL DRILLERS LOG  
WASTE DRILLING & SERVICE CO.

ROUTE 1 BOX 618

JACKSON

BILOXI MISS. 39532

county well located

Jackson  
N 2249  
7-18-84

7/18/84  
date well completed

LANDOWNER: Gary Simmons

Ocean Springs, Miss

(mailing address)

WELL LOCATION:

sec. 19 T-7 N R-8 E  
Ocean Springs  
(distance) (direction) (nearest town)

WELL PURPOSE:

(home, irrigation, municipal, industrial)

WELL COMPLETION DATA:

- (1) diameter (inches) 2'
- (2) total depth (feet) 470
- (3) static water level (feet) 20 <sup>below</sup> above top of ground.
- (4) casing PVC, 460,  
(material) (depth)  
10' if telescope see back.  
(size)
- (5) screen 10', 460  
(length) (depth to top)  
2', PVC  
(size) (material)
- (6) pump 1, 28 10  
(HP) (yield gpm)  
ELC.  
(type power)
- (7) electric log NO  
(yes or no)

(organization running log)

- (8) how well bottom plugged 2' back-wash  
scave 19-13

DRILLERS REMARKS:


description of formations encountered	from	to
top soil	1	3
red clay	3	20
course white sand	20	90
sugar sand	90	130
soft blue clay	130	330
fine water sand	330	365
rock + shell	365	400
hard blue clay	400	440
fine sand	440	460
good water sand	460	470

RECEIVED  
JUL 22 1985

Department of Natural Resources  
Bureau of Land & Water Resources

If well telescopes please sketch and show depths.

GROUND LEVEL

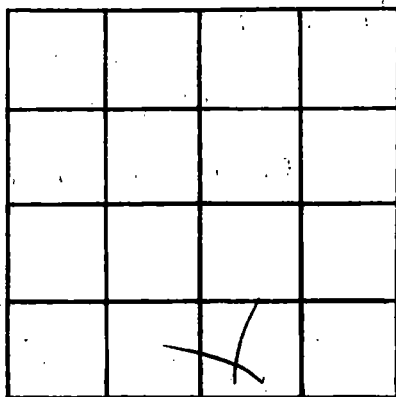

SECTION \_\_\_\_\_

Please indicate well location X.

ADDITIONAL INFORMATION

If more than one screen, show locations of each on sketch.