

MISSISSIPPI DEPARTMENT OF NATURAL RESOURCES

Bureau of Land and Water Resources

Southport Mall

P.O. Box 10631

Jackson, Mississippi 39209

WATER WELL DRILLERS LOG

JACKSON
N 2252

6-26-85 19 Coast Water Well Sew. Jackson
date well completed firm name county well located

LANDOWNER: Joe English

description of formations encountered from to

6104 N. Washington

Top soil 0 3'

Ocean Springs, Miss.
(mailing address) 39564

Red Med. sand 3' 6'

WELL LOCATION:

White Coarse sand 6' 60'

sec. 18 T. 7N R. 8E
IN miles (distance) (direction) of SEAN SPRINGS (nearest town)

WELL PURPOSE: None
(home, irrigation, municipal, industrial)

WELL COMPLETION DATA:

(1) diameter (inches) 2"

(2) total depth (feet) 60'

(3) static water level (feet) 24' ^{below} / _{above} top of ground.

(4) casing PVC 50'
(material) (depth)

2" if telescope see back.
(size)

(5) screen 10' 50'
(length) (depth to top)

2" PVC
(size) (material)

(6) pump 1/2 hp 6
(HP) (yield gpm)


Elect.
(type power)

(7) electric log No
(yes or no)

(organization running log)

(8) has well bottom plugged
Jack Work Value


DRILLERS REMARKS: _____

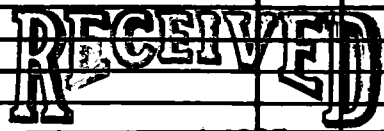

NOV -1 1985

If well telescopes please sketch and show depths.

GROUND LEVEL

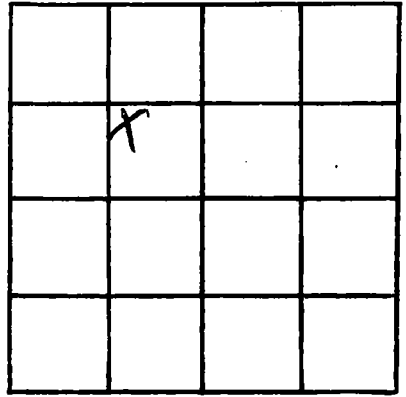

SECTION B

Please indicate well location X.

ADDITIONAL INFORMATION

A series of horizontal lines for writing additional information, starting below the 'ADDITIONAL INFORMATION' header and extending to the bottom of the page.

If more than one screen, show locations of each on sketch.