

MISSISSIPPI DEPARTMENT OF NATURAL RESOURCES

Bureau of Land and Water Resources

Southport Mall

P.O. Box 10631

Jackson, Mississippi 39209

WATER WELL DRILLERS LOG

Jackson  
N 2853

6-25-85  
date well completed

Coast Water Well Sew.  
firm name

Jackson  
county well located

LANDOWNER:

Charles W Randall  
12920 Harbour Dr.

description of formations encountered

from

to

Ocean Springs, Miss.  
(mailing address) 39564

<u>Red Clay</u>	<u>0</u>	<u>6'</u>
<u>White Clay</u>	<u>6'</u>	<u>12'</u>
<u>Blue Clay</u>	<u>12'</u>	<u>16'</u>
<u>Red Med. &amp; Coarse Sand</u>	<u>16'</u>	<u>47'</u>
<u>Sub at 45'</u>		

WELL LOCATION:

sec. 18 T. 7 S. R. 8 W.  
1N miles (distance) (direction) of Ocean Springs (nearest town)

WELL PURPOSE:

(home, irrigation, municipal, industrial)

Home

WELL COMPLETION DATA:

- (1) diameter (inches) 2"
- (2) total depth (feet) 45'
- (3) static water level (feet) 26' <sup>below</sup> <sub>above</sub> top of ground.
- (4) casing PVC, 40'  
(material) (depth)  
2" if telescope see back.  
(size)
- (5) screen 5', 40'  
(length) (depth to top)  
2", PVC  
(size) (material)
- (6) pump — (HP) — (yield gpm)  
Electric  
(type power)
- (7) electric log No (yes or no)
- (organization running log)
- (8) how well bottom plugged  
Back Wash Valve

RECEIVED


NOV - 1 1985

DRILLERS REMARKS:

Department of Natural Resources  
Bureau of Land & Water Resources

If well telescopes please sketch and show depths.

GROUND LEVEL

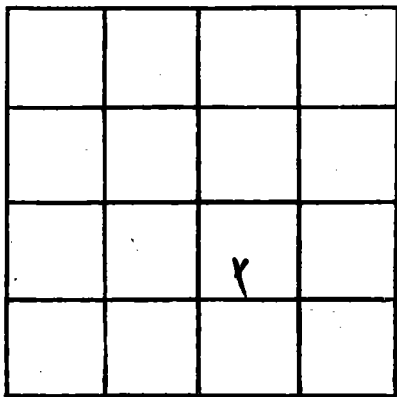

SECTION 18

Please indicate well location X.

ADDITIONAL INFORMATION

If more than one screen, show locations of each on sketch.