

MISSISSIPPI DEPARTMENT OF NATURAL RESOURCES

Bureau of Land and Water Resources

Southport Mall

P.O. Box 10631

Jackson, Mississippi 39209

WATER WELL DRILLERS LOG

Jackson
N 27.55

7-2-85

Coast Water Well Sew. Jackson

date well completed

firm name

county well located

LANDOWNER:

Harold Mitchell

description of formations encountered

from to

103 LaBrance

Top soil

0 2'

Ocean Springs, Miss
(mailing address) 37564

White coarse sand

2' 5'

Blue Clay & clam shells

5' 40'

WELL LOCATION:

sec. 32 T 7 N R 8 E
IN miles (distance) of (direction) of OCEAN SPRINGS (nearest town)

Gray coarse sand & Shale

40' 68'

WELL PURPOSE:

(home, irrigation, municipal, industrial)

Blue Clay

68' 70'

WELL COMPLETION DATA:

- (1) diameter (inches) 2"
- (2) total depth (feet) 70'
- (3) static water level (feet) 19' below top of ground.
- (4) casing PVC 60' (material) (depth)
- 2" (size) if telescope see back.
- (5) screen 10' 60' (length) (depth to top)
- 2" PVC (size) (material)
- (6) pump (HP) (yield gpm)
- Electric (type power)
- (7) electric log No (yes or no)
- (organization running log)
- (8) how well bottom plugged Jack Wash Valve

8'-2" Tail pipe

RECEIVED


NOV - 1 1985

DRILLERS REMARKS:

Department of Natural Resources
Bureau of Land & Water Resources

If well telescopes please sketch and show depths.

GROUND LEVEL

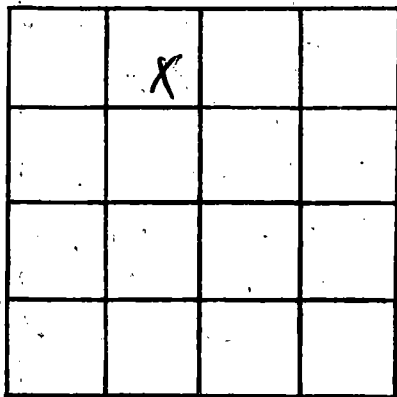

SECTION 32

Please indicate well location X.

ADDITIONAL INFORMATION

If more than one screen, show locations of each on sketch.