

MISSISSIPPI DEPARTMENT OF NATURAL RESOURCES

Bureau of Land and Water Resources

Southport Mall

P.O. Box 10631

Jackson, Mississippi 39209

WATER WELL DRILLERS LOG

JACKSON
N 2756

7-2-85
date well completed

Coast Water Well Sew.
firm name

Jackson
county well located

LANDOWNER:

Louis Keifer
6816 Natchez
Biloxi, Miss. 39532
(mailing address)

description of formations encountered

from to

Top soil 0 3'
Red Clay 3' 18'
Red Coarse Sand & gravel 18' 30'
Blue Clay 30' 70'
Rock 70-6"

WELL LOCATION:

sec. 15 T. 7 N R. 9 W
IN miles (distance) (direction) of DIBERVILLE (nearest town)

WELL PURPOSE:

(home, irrigation, municipal, industrial)

WELL COMPLETION DATA:

- (1) diameter (inches) 2"
- (2) total depth (feet) 160
- (3) static water level (feet) 18' below top of ground
- (4) casing PVC 150' (material) (depth)
2" (size) if telescope see back.
- (5) screen 10' 150' (length) (depth to top)
2" PVC (size) (material)
- (6) pump (HP) (yield gpm)
Clark (type power)
- (7) electric log No (yes or no)
(organization running log)

Blue Clay 70' 129'
Wing Coarse Sand 129' 155'
Blue Clay 155' 160'
5'-3" Tail Pipe

(8) has well bottom plugged
Back Wash Valve

DRILLERS REMARKS:


RECEIVED

NOV -1 1985

Department of Natural Resources
Bureau of Land & Water Resources

If well telescopes please sketch and show depths.

GROUND LEVEL

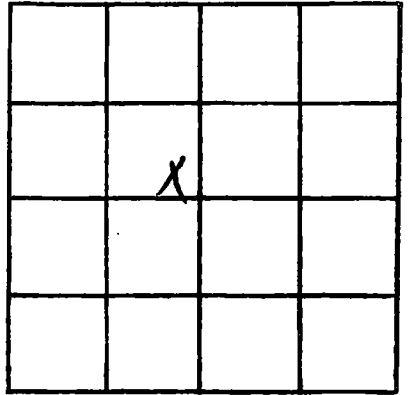

SECTION 15

Please indicate well location X.

ADDITIONAL INFORMATION

If more than one screen,
show locations of each on sketch.