

MISSISSIPPI DEPARTMENT OF NATURAL RESOURCES

Bureau of Land and Water Resources

Southport Mall

P.O. Box 10631

Jackson, Mississippi 39209

WATER WELL DRILLERS LOG

JACKSON  
N 2259

10-14-85

date well completed

Coast Water Well

firm name

Jackson

county well located

LANDOWNER: KARRY FERANDA  
615 Coveaux St.  
Biloxi, Miss.  
(mailing address) 392530

Description of formations encountered

from

to

WELL LOCATION:  
sec. 2 T. 7 N. R. 9  
2 miles N of D'IBERVILLE  
(distance) (direction) (nearest town)

Top soil

0 3

Red Clay

3 13

Red Coarse Sand

13 45

Blue Clay + streak  
of sand

45 88

Blue Clay

88 240

Gray Coarse Sand

240 255

Blue Clay

255 312

Blue fine sand

312 323

Blue Clay

323 387

Gray Coarse Sand

387 437

Blue Clay

437 440

hole

WELL PURPOSE: None  
(home, irrigation, municipal, industrial)

WELL COMPLETION DATA:

(1) diameter (inches) 2"  
(2) total depth (feet) 440'  
(3) static water level (feet) 62 <sup>below</sup>/<sub>above</sub> top of ground.

(4) casing PVC, 425'  
(material) (depth)  
2"  
(size) if telescope see back.

(5) screen 10', 425'  
(length) (depth to top)  
2", PVC  
(size) (material)

(6) pump \_\_\_\_\_  
(HP) (yield gpm)  
\_\_\_\_\_  
(type power)

(7) electric log no  
(yes or no)  
\_\_\_\_\_  
(organization running log)

(8) how well bottom plugged  
Backwash valve

DRILLERS REMARKS:

5'-2" tail pipe


RECEIVED

NOV 26 1985

Department of Natural Resources  
Bureau of Land & Water Resources

If well telescopes please sketch and show depths.

GROUND LEVEL

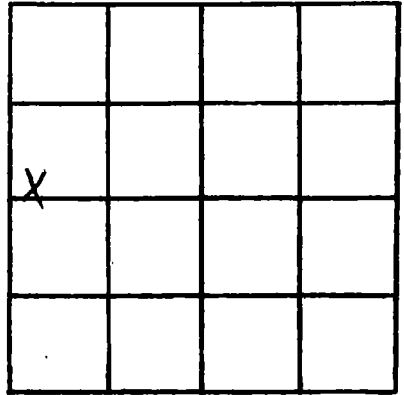

SECTION 2

Please indicate well location X.

ADDITIONAL INFORMATION

If more than one screen, show locations of each on sketch.