

MISSISSIPPI DEPARTMENT OF NATURAL RESOURCES

Bureau of Land and Water Resources

Southport Mall

P.O. Box 10631

Jackson, Mississippi 39209

WATER WELL DRILLERS LOG

Jackson
N 2760

10-22-85
date well completed

Coast water well
firm name

Jackson
county well located

LANDOWNER: Dr. Mary Wilson
8401 Seaman Rd.
Ocean Springs, Miss.
(mailing address) 39564

WELL LOCATION:
sec. 1 T. 7 N. R. 9 E.
3 1/2 miles (distance) N (direction) of OCEAN SPRINGS (nearest town)

WELL PURPOSE: None
(home, irrigation, municipal, industrial)

WELL COMPLETION DATA:

(1) diameter (inches) 2"

(2) total depth (feet) 740'

(3) static water level (feet) 38 below top of ground.

(4) casing PVC 715' CL
(material) (depth)

2" (size) If telescope see back.

(5) screen 20' 715'
(length) (depth to top)

2" (size) PVC (material)

(6) pump _____ (HP) _____ (yield gpm)

_____ (type power)

(7) electric log no (yes or no)

_____ (organization running log)

(8) how well bottom plugged Backward valve

description of formations encountered	from	to
Top soil	0'	2'
Red Clay	2'	11'
Blue Clay	11'	20'
Red Coarse sand	20'	45'
Red Coarse Sand + Wood	45'	60'
Blue Clay + Oyster Shell	60'	260'
Blue Clay	260'	327'
Blue Clay + streak of sand	327'	349'
Blue Clay	349'	678'
Gray Fine Sand	678'	688'
Gray med sand	688'	710'
Gray Coarse sand	710'	735'
Blue Clay	735'	740'
		Hole


RECEIVED
NOV 26 1985

Department of Natural Resources
Bureau of Land & Water Resources

DRILLERS REMARKS:
5' - 2" tail pipe

If well telescopes please sketch and show depths.

GROUND LEVEL

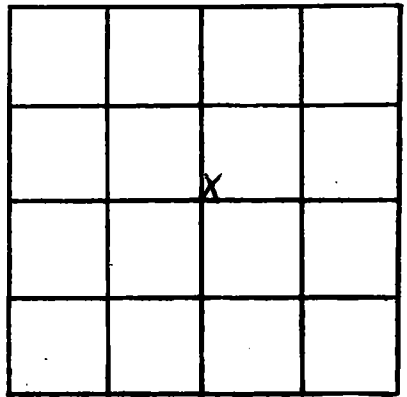

SECTION /

Please indicate well location X.

ADDITIONAL INFORMATION

If more than one screen, show locations of each on sketch.