

MISSISSIPPI DEPARTMENT OF NATURAL RESOURCES

Bureau of Land and Water Resources

Southport Mall

P.O. Box 10631

Jackson, Mississippi 39209

WATER WELL DRILLERS LOG

JACKSON
N 2912

Nov. 7 85
date well completed


Coast Water Well Sew. Jackson
firm name county well located

LANDOWNER: Don Turner
#10 Franklin Road
Ocean Springs, MS -
(mailing address) 37564
WELL LOCATION:
sec 34 T 7 N R 8 E
1 miles EAST of Ocean Springs
(distance) (direction) (nearest town)

WELL PURPOSE: Home
(home, irrigation, municipal, industrial)

WELL COMPLETION DATA:
(1) diameter (inches) 4" x 2"
(2) total depth (feet) 541'
(3) static water level (feet) 58' below top of ground.
(4) casing PVC 511' (material) (depth)
4" x 2" (size) if telescope see back.
(5) screen 20' 511' (length) (depth to top)
4" x 2" (size) PVC (material)
(6) pump 1-1/2 hp Subm. Pump 20 (HP) (yield gpm)
Select. (type power)
(7) electric log No (yes or no)
(organization running log)
(8) how well bottom plugged Backwash Valve

description of formations encountered	from	to
Top soil	0	5'
Red fine sand	5'	9'
Red Clay	9'	17'
Blue Clay	17'	40'
Blue Clay & Clay shell	40'	62'
White coarse sand	62'	83'
Blue Clay	83'	400'
Gray med sand	400'	413'
Blue Clay	413'	491'
Gray coarse sand	491'	531'
red gravel	531'	538'
Blue Clay	538'	541'
		511'
		20'
		531'

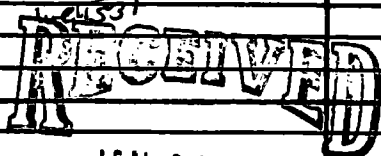


JAN 03 1986

Department of Natural Resources
Bureau of Land & Water Resources

DRILLERS REMARKS:
2" PVC 10" Tail Pipe

If well telescopes please sketch and show depths.

GROUND LEVEL

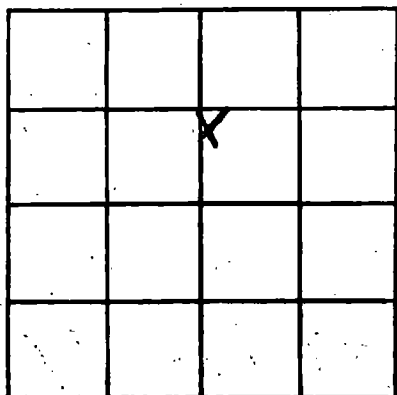

SECTION 34

Please indicate well location X.

ADDITIONAL INFORMATION

If more than one screen, show locations of each on sketch.