

MISSISSIPPI DEPARTMENT OF NATURAL RESOURCES

Bureau of Land and Water Resources

Southport Mall

P.O. Box 10631

Jackson, Mississippi 39209

WATER WELL DRILLERS LOG

JACKSON
N 2265

12-4-85 19 Coastwater well Jackson
 date well completed firm name county well located

LANDOWNER: Eric Aldrich
13604 Gaffville Rd.
Ocean Springs, Ms.
 (mailing address) 3754

WELL LOCATION:
 sec. 12 T. 7 S. R. 9 W.
2 miles N of OCEAN SPRINGS
 (distance) (direction) (nearest town)

WELL PURPOSE: home
 (home, irrigation, municipal, industrial)

WELL COMPLETION DATA:
 (1) diameter (inches) 2"
 (2) total depth (feet) 41.5 ft.
 (3) static water level (feet) 70 ft. ^{below} top of ground.
 (4) casing PVC, 450' CL
 (material) (depth)
2" If telescope see back.
 (size)
 (5) screen 10' 450'
 (length) (depth to top)
2" PVC
 (size) (material)
 (6) pump 1 hp. 6
 (HP) (yield gpm)
elec.
 (type power)
 (7) electric log no
 (yes or no)
 (organization running log)
 (8) how well bottom plugged backwash valve

description of formations encountered	from	to
Top Soil	0'	2'
Red Sand	2'	4'
Red Clay	4'	10'
Blue Clay	10'	35'
White Coarse Sand w/ Gravel	35'	101'
Blue Clay	101'	330'
Streaks of Sand	330'	345'
Blue Clay	345'	405'
Gray Coarse Sand	405'	41.5'
		Half


RECEIVED
 FEB - 7 1986

Department of Natural Resources
 Bureau of Land & Water Resources

DRILLERS REMARKS:
5ft - 2" PVC tail pipe

If well telescopes please sketch and show depths.

GROUND LEVEL

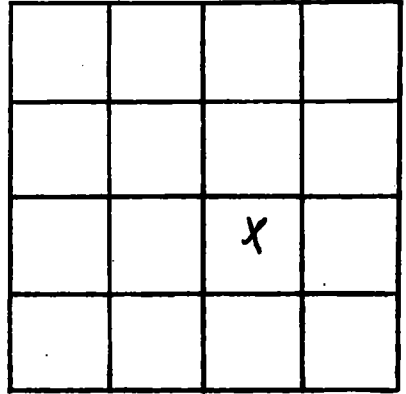

SECTION 12

Please indicate well location X.

ADDITIONAL INFORMATION

If more than one screen, show locations of each on sketch.