

MISSISSIPPI DEPARTMENT OF NATURAL RESOURCES

Bureau of Land and Water Resources

Southport Mall

P.O. Box 10631

Jackson, Mississippi 39209

WATER WELL DRILLERS LOG

JACKSON
N 2267

12-7-85 19 Coast Water Well Serv. Jackson
date well completed firm name county well located

LANDOWNER: Frontier Homes
P.O. Box 1266
Pascagoula Miss.
(mailing address) 39567

WELL LOCATION:
sec. 13 T. 7 N. R. 8 E
1 1/2 miles NE of OCEAN SPRINGS
(distance) (direction) (nearest town)

WELL PURPOSE: home
(home, irrigation, municipal, industrial)

WELL COMPLETION DATA:

(1) diameter (inches) 2"

(2) total depth (feet) 378'

(3) static water level (feet) 63' ^{below} _{above} top of ground.

(4) casing PVC, 263' (material) (depth)
2" (size) if telescope see back.

(5) screen 10' (length), 268' (depth to top)
2" (size), PVC (material)

(6) pump 1 hp. (HP), 8 (yield gpm)
elec. (type power)

(7) electric log no (yes or no)

(organization running log)

(8) how well bottom plugged Back Wash Valve

description of formations encountered	from	to
<u>Top soil</u>	<u>0</u>	<u>1'</u>
<u>Blue Clay</u>	<u>1'</u>	<u>15'</u>
<u>White Coarse sand</u>	<u>15'</u>	<u>25'</u>
<u>Blue Clay</u>	<u>25'</u>	<u>65'</u>
<u>Med. Sand</u>	<u>65'</u>	<u>80'</u>
<u>Blue Clay</u>	<u>80'</u>	<u>105'</u>
<u>Med. Sand</u>	<u>105'</u>	<u>119'</u>
<u>Blue Clay</u>	<u>119'</u>	<u>335'</u>
<u>Med. Sand</u>	<u>335'</u>	<u>360'</u>
<u>Gray Coarse Sand</u>	<u>360'</u>	<u>378'</u>

763
10
13
RECEIVED


FEB - 7 1986

Department of Natural Resources
Bureau of Land & Water Resources

DRILLERS REMARKS:
5' - 2" PVC Tail Pipe
1' - Screen Catcher

If well telescopes please sketch and show depths.

GROUND LEVEL

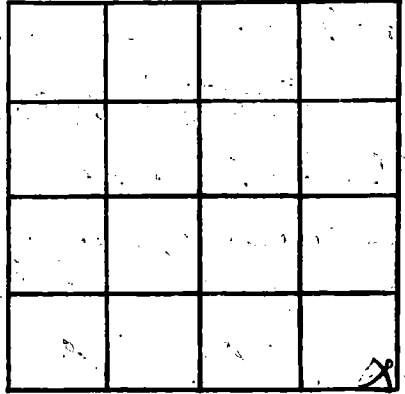

SECTION 13

Please indicate well location X.

ADDITIONAL INFORMATION

If more than one screen, show locations of each on sketch.