

MISSISSIPPI DEPARTMENT OF NATURAL RESOURCES

Bureau of Land and Water Resources

Southport Mall

P.O. Box 10631

Jackson, Mississippi 39209

WATER WELL DRILLERS LOG

JACKSON  
N 2768

12-23-85 19 *Coast Water Well Sew. Jackson*  
date well completed firm name county well located

LANDOWNER: *Judy Davison*

description of formations encountered from to

8104 *Lee Ch. C. Camp Road*  
*Ocean Springs, MS.*  
(mailing address) *39564*

<i>Top soil</i>	<i>0</i>	<i>2'</i>
<i>Brown Clay</i>	<i>2'</i>	<i>10'</i>
<i>Blue Clay</i>	<i>10'</i>	<i>30'</i>
<i>White Camp sand</i>	<i>30'</i>	<i>50'</i>
<i>Blue Clay</i>	<i>50'</i>	<i>70'</i>

WELL LOCATION:  
sec. *23* T. *7* N. R. *8* E.  
*1/2* miles *EAST* of *OCEAN SPRINGS*  
(distance) (direction) (nearest town)

WELL PURPOSE: *home*  
(home, irrigation, municipal, industrial)

WELL COMPLETION DATA:

- (1) diameter (inches) 2"
- (2) total depth (feet) 70'
- (3) static water level (feet) 25' <sup>below</sup> <sub>above</sub> top of ground.
- (4) casing PVC (material), 40' (depth)  
2" (size) if telescope see back.
- (5) screen 10' (length), 40' (depth to top)  
2" (size), PVC (material)
- (6) pump \_\_\_\_\_ (HP) \_\_\_\_\_ (yield gpm)  
(type power) \_\_\_\_\_
- (7) electric log no (yes or no)  
(organization running log) \_\_\_\_\_
- (8) how well bottom plugged \_\_\_\_\_

*40  
10  
= 50*

**RECEIVED**


FEB - 7 1986

Department of Natural Resources  
Bureau of Land & Water Resources

DRILLERS REMARKS:  
*Log - 2" Tail Pipe  
Shut Catcher*

If well telescopes please sketch and show depths.

GROUND LEVEL

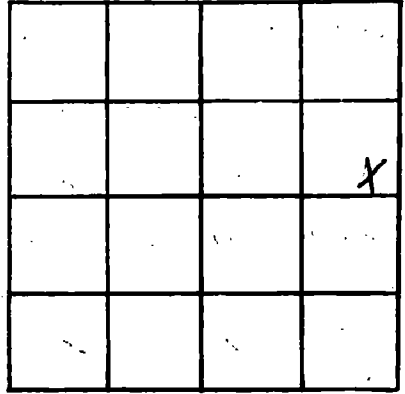

SECTION 23

Please indicate well location X.

ADDITIONAL INFORMATION

If more than one screen, show locations of each on sketch.