

MISSISSIPPI DEPARTMENT OF NATURAL RESOURCES

Bureau of Land and Water Resources

Southport Mall

P.O. Box 10631

Jackson, Mississippi 39209

WATER WELL DRILLERS LOG

COASTAL DRILLING & SERVICE CO.

JACKSON
N 2271

12/25/85
date well completed

RT. 11, BOX 81 name

JACKSON
county well located

LANDOWNER: GOE THOMAS

description of formations encountered	from	to
top soil	1	5
sugar sand	5	20
red clay	20	180
blue clay	180	320
red clay	320	465
fine water sand	465	500
loose blue clay	500	640
hard blue clay	640	800
fine water sand	800	830
good water sand	830	850
		1612

Rt. 5
Ocean Springs, MS
(mailing address)


WELL LOCATION:
sec. 22 T 7 S R 8 E
Ocean Springs
(distance) (direction) (nearest town)

WELL PURPOSE: none
(home, irrigation, municipal, industrial)

WELL COMPLETION DATA:

- (1) diameter (inches) 2"
- (2) total depth (feet) 850
- (3) static water level (feet) 150 below top of ground.
- (4) casing PVC, 835 (material) (depth) (size) If telescope see back.
- (5) screen 10' 835 (length) (depth to top) 2" (size) PVC (material)
- (6) pump 2 13 (HP) (yield gpm) ETC (type power)
- (7) electric log NO (yes or no)
- (organization running log)
- (8) how well bottom plugged 2" WACK wash valve.


DRILLERS REMARKS:

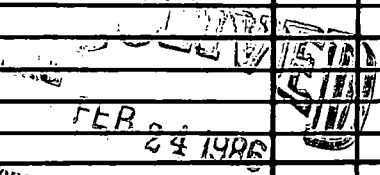

Department of Natural Resources
Bureau of Land & Water Resources

If well telescopes please sketch and show depths.

GROUND LEVEL

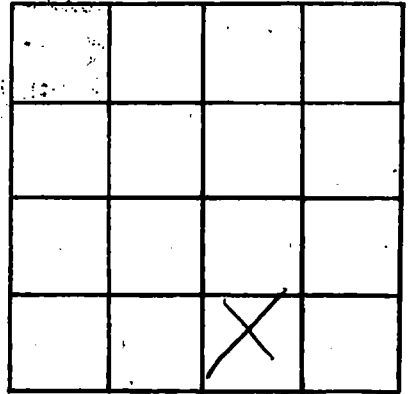

SECTION _____

Please indicate well location X.

ADDITIONAL INFORMATION

If more than one screen,
show locations of each on sketch.