

**MISSISSIPPI DEPARTMENT OF NATURAL RESOURCES**  
**Bureau of Land and Water Resources**  
 Southport Mall  
 P.O. Box 10631  
 Jackson, Mississippi 39209  
**WATER WELL DRILLERS LOG**

Jackson  
N 7273

1/7/86 19 COASTAL DRILLING & SERVICE CO. Jackson  
 date well completed firm name county well located  
RT. 11, BOX 81  
 DILGAT, MS

LANDOWNER: Mike Armstrong  
Mountain Blue  
Ocean Springs, MS  
 (mailing address)  
 WELL LOCATION:  
 sec. 18 T. 7 N. R. 8 E.  
Ocean Springs  
 (distance) (direction) (nearest town)

description of formations encountered	from	to
<u>top soil</u>	<u>1</u>	<u>15</u>
<u>red clay</u>	<u>15</u>	<u>210</u>
<u>blue clay</u>	<u>210</u>	<u>475</u>
<u>good well sand</u>	<u>475</u>	<u>490</u>

WELL PURPOSE: home  
 (home, irrigation, municipal, industrial)

WELL COMPLETION DATA:  
 (1) diameter (inches) 2"  
 (2) total depth (feet) 490  
 (3) static water level (feet) 10 below top of ground.  
 (4) casing PVC 480  
 (material) (depth)  
 (size) if telescope see back.  
 (5) screen 18' 480  
 (length) (depth to top)  
2" PVC  
 (size) (material)  
 (6) pump 1 9  
 (HP) (yield gpm)  
elc  
 (type power)  
 (7) electric log no  
 (yes or no)  
 (organization running log)  
 (8) how well bottom plugged 2" back wash valve


**RECEIVED**  
 MAY 19 1986

DRILLERS REMARKS:

Department of Natural Resources  
 Bureau of Land & Water Resources

If well telescopes please sketch and show depths.

GROUND LEVEL

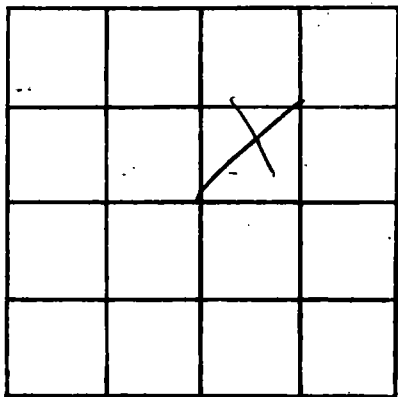

SECTION \_\_\_\_\_

Please indicate well location X.

ADDITIONAL INFORMATION

If more than one screen,  
show locations of each on sketch.