

MISSISSIPPI DEPARTMENT OF NATURAL RESOURCES

Bureau of Land and Water Resources

Southport Mall

P.O. Box 10631

Jackson, Mississippi 39209

WATER WELL DRILLERS LOG

Jackson
N 2279

2/26/86 19
date well completed

Coast Water Well Serv. Jackson
firm name county well located

LANDOWNER: David Beckenroth
Bayou Pine Dr.
North Belvoir
(mailing address)

WELL LOCATION:
sec 13 T 7 N R 9 E
IN miles of DIBERVILLE
(distance) (direction) (nearest town)

WELL PURPOSE: home
(home, irrigation, municipal, industrial)

WELL COMPLETION DATA:

- (1) diameter (inches) 4 x 2"
- (2) total depth (feet) 474'
- (3) static water level (feet) 62' ^{below} above top of ground
- (4) casing PVC 200' (4")
249' (2")
4x2 (size) if telescope see back. well 469
- (5) screen 20' 449' ^{cl}
(length) (depth to top)
2" PVC
(size) (material)
- (6) pump 20
(HP) (yield: gpm)
Elect
(type power)
- (7) electric log no
(yes or no)
- (organization running log)
- (8) how well bottom plugged Backwash valve


DRILLERS REMARKS:
5' 2" PVC tail pipe

Description of formations encountered	from	to
Top Soil	0	3
Red Clay	3	20
Blue Clay	20	270
Gray Coarse Sand	270	290
Blue Clay	290	400
Gray Coarse Sand	400	469
Gray Coarse Sand & Gravel	469	474

RECEIVED
MAY 12 1986

Department of Natural Resources
Bureau of Land & Water Resources

If well telescopes please sketch and show depths.

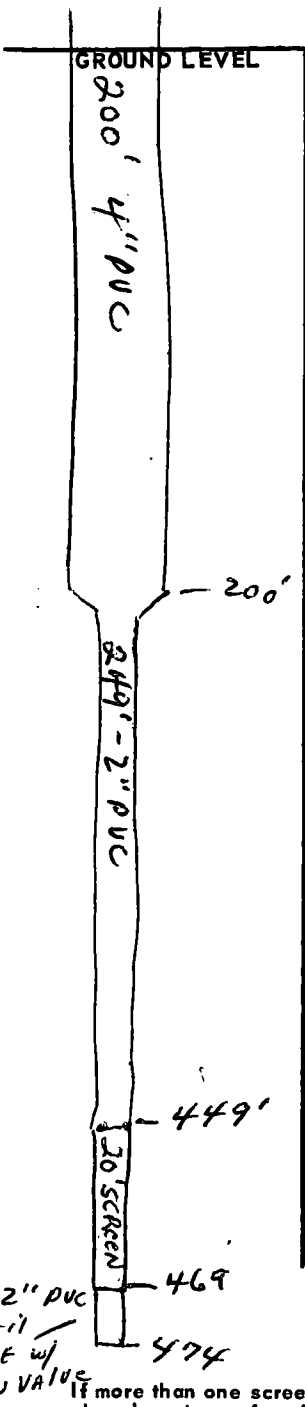

X			

SECTION 13

Please indicate well location X.

ADDITIONAL INFORMATION

A series of horizontal lines providing space for additional information.

If more than one screen, show locations of each on sketch.