

MISSISSIPPI DEPARTMENT OF NATURAL RESOURCES

Bureau of Land and Water Resources

Southport Mall

P.O. Box 10631

Jackson, Mississippi 39209

WATER WELL DRILLERS LOG

JACKSON  
N 2275

3/11/86  
date well completed

Coast Water Well Inc Jackson  
firm name county well located

LANDOWNER	Description of formations encountered	from	to
102 LEIGH CIRCLE	White Coarse Sand	0	13
OCEAN SPRINGS MS (mailing address) 39564	Blue Clay	13	55
WELL LOCATION: sec. 34 T. 7 N R. 8 E 1/2 miles (distance) SE of OCEAN SPRINGS (nearest town)	White Coarse Sand	55	130
WELL PURPOSE: home (home, irrigation, municipal, industrial)	Blue Clay	130	145
WELL COMPLETION DATA: (1) diameter (inches) 2" (2) total depth (feet) 450' (3) static water level (feet) 55 below top of ground (4) casing (material) PVC (depth) 435' well 45' 2" (size) If telescope see back. (5) screen 10' (length) 435' (depth to top) 2" (size) PVC (material) (6) pump 1 (HP) 8 (yield gpm) Elet (type power) (7) electric log no (yes or no) (organization running log) (8) how well bottom plugged Backwash valve	Med Gray Sand	145	183
	Blue Clay	183	400
	Gray	400	450


REGISTERED  
MAY 12 1986

Department of Natural Resources  
Bureau of Land & Water

DRILLERS REMARKS:  
5' 2" PVC tail pipe

If well telescopes please sketch and show depths.

GROUND LEVEL

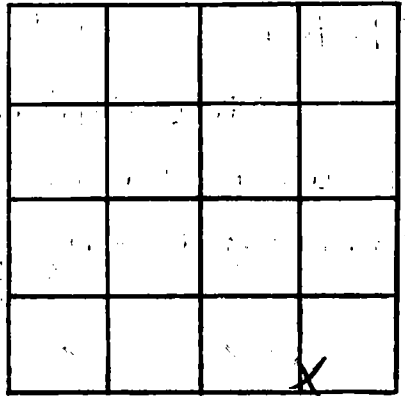

SECTION 34

Please indicate well location X.

ADDITIONAL INFORMATION

If more than one screen, show locations of each on sketch.