

MISSISSIPPI DEPARTMENT OF NATURAL RESOURCES
Bureau of Land and Water Resources
 Southport Mall
 P.O. Box 10631
 Jackson, Mississippi 39209
WATER WELL DRILLERS LOG

JACKSON
N 2276

3/21/80 19
 date well completed

COASTAL DRILLING & SERVICE CO.
RT. 11, BOX 87

Jackson
Harrison
 county well located

LANDOWNER: JACKSON, MS 39532
Merry Farm Rd.
Ocean Springs, MS
 (mailing address)

description of formations encountered	from	to
<u>top soil</u>	<u>1</u>	<u>5</u>
<u>red clay</u>	<u>5</u>	<u>185</u>
<u>good water sand</u>	<u>185</u>	<u>195</u>

WELL LOCATION:
 sec. 18 T. 7 N. R. 8 W.
Ocean Springs
 (distance) (direction) (nearest town)

WELL PURPOSE: home
 (home, irrigation, municipal, industrial)

WELL COMPLETION DATA:

(1) diameter (inches) 2"

(2) total depth (feet) 195

(3) static water level (feet) 10 below
 top of ground. ground

(4) casing pvc 185, 1
 (material) (depth)
 (size) if telescope see back.

(5) screen 10, 185
 (length) (depth to top)
2", pvc
 (size) (material)


(6) pump 1, 10
 (HP) (yield gpm)
gla
 (type power)

(7) electric log no
 (yes or no)

(organization running log)

(8) how well bottom plugged 2" back
wash valve

DRILLERS REMARKS:

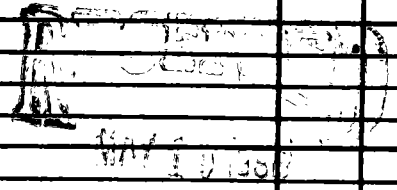

Department of Natural Resources
 Bureau of Land & Water Resources

