

MISSISSIPPI DEPARTMENT OF NATURAL RESOURCES

Bureau of Land and Water Resources

Southport Mall

P.O. Box 10631

Jackson, Mississippi 39209

WATER WELL DRILLERS LOG


JACKSON  
J N 2877

3-27-86 19 COAST WATER WELL JACKSON  
date well completed firm name county well located

LANDOWNER	description of formations encountered	from	to
JUDY BAUVOLIA			
old CCC Camp Rd	TOP SOIL	0	1
OCEAN SPRINGS MS (mailing address)	BLUE CLAY	1	40
WELL LOCATION: sec. 24 T 7 N R 8 E 3/4 miles EAST of OCEAN SPRINGS (distance) (direction) (nearest town)	WHITE COARSE SAND	40	58
WELL PURPOSE: HOME (home, irrigation, municipal, industrial)	BLUE CLAY	58	118
WELL COMPLETION DATA: (1) diameter (inches) 2" (2) total depth (feet) 410' (3) static water level (feet) 55 below above top of ground. (4) casing PVC 395' (material) (depth) 2" (size) if telescope see back. (5) screen 10' 395' (length) (depth to top) 2" PVC (material) (size) (6) pump 1hp 8 (HP) (yield gpm) elect. (type power) (7) electric log no (yes or no) (organization running log) (8) how well bottom plugged BACKWASH VALVE	FINE GRAY SAND	118	133
	BLUE CLAY	133	149
	MED. GRAY SAND	149	162
	BLUE CLAY	162	210
	MED. GRAY SAND	210	220
	BLUE CLAY	220	255
	FINE SAND	255	269
	BLUE CLAY	269	365
	GRAY FINE SAND	365	378
	BLUE CLAY	378	380
	MED GRAY SAND	380	405
	BLUE CLAY	405	410
DRILLERS REMARKS: 5' - 2" PVC TAILPIPE	RECEIVED MAY 12 1986 Department of Natural Resources Bureau of Land & Water Resources		

If well telescopes please sketch and show depths.

GROUND LEVEL

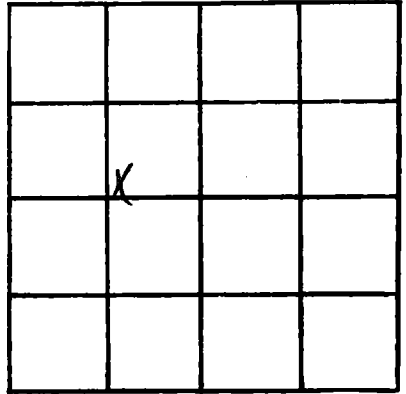

SECTION 24

Please indicate well location X.

ADDITIONAL INFORMATION

If more than one screen, show locations of each on sketch.