

MISSISSIPPI DEPARTMENT OF NATURAL RESOURCES

Bureau of Land and Water Resources

Southport Mall

P.O. Box 10631

Jackson, Mississippi 39209

WATER WELL DRILLERS LOG

JACKSON
N 2279

4-3
date well completed

19

86 Coast Water Well Jackson

firm name

city well located

LANDOWNER:	description of formations encountered	from	to
Jerry Platt P.O. Box 647 Ocean Springs, Miss. (mailing address) 37564	Top soil	0	2
	Blue Clay	2	13
	White Coarse Sand	13	25
	Blue Clay	25	70
	White Coarse Sand	70	113
	Blue Clay	113	177
	Med. Gray Sand	177	184
	Blue Clay	184	220
	Med. Gray Sand	220	238
	Blue Clay	238	288
	Fine Sand	288	300
	Blue Clay	300	310
	Gray Coarse Sand	310	340
	Blue Clay	340	345
	well 340		hole
<p>RECEIVED</p> <p>MAY 12 1986</p>			
<p>Department of Natural Resources Bureau of Land & Water Resources</p>			
<p>DRILLERS REMARKS: 5' 2" pvc tail pipe</p>			

LANDOWNER: Jerry Platt

description of formations encountered

from to

P.O. Box 647

Top soil

0 2

Ocean Springs, Miss.
(mailing address) 37564

Blue Clay

2 13

WELL LOCATION:

White Coarse Sand

13 25

sec. 13 T 7 N R 8 E
2 miles NE of Ocean Springs
(distance) (direction) (nearest town)

Blue Clay

25 70

WELL PURPOSE: Home
(home, irrigation, municipal, industrial)

White Coarse Sand

70 113

WELL COMPLETION DATA:

Blue Clay

113 177

(1) diameter (inches) 2"

Med. Gray Sand

177 184

(2) total depth (feet) 345'

Blue Clay

184 220

(3) static water level (feet) 30' below top of ground.

Med. Gray Sand

220 238

(4) casing PVC, 330'
(material) (depth)

Blue Clay

238 288

2" If telescope see back.
(size)

Fine Sand

288 300

(5) screen 10' 330'
(length) (depth to top)

Blue Clay

300 310

2" PVC
(size) (material)

Gray Coarse Sand

310 340

(6) pump 1/2 HP, 11
(HP) (yield gpm)

Blue Clay

340 345

Electric
(type power)

well 340

(7) electric log NO
(yes or no)

(organization running log)

(8) how well bottom plugged
backwash valve

DRILLERS REMARKS:

5' 2" pvc tail pipe


RECEIVED

MAY 12 1986

Department of Natural Resources
Bureau of Land & Water Resources

If well telescopes please sketch and show depths.

GROUND LEVEL

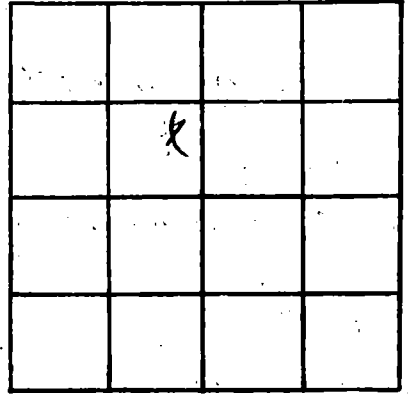

SECTION 13

Please indicate well location X.

ADDITIONAL INFORMATION

If more than one screen,
show locations of each on sketch.