

MISSISSIPPI DEPARTMENT OF NATURAL RESOURCES

Bureau of Land and Water Resources

Southport Mall

P.O. Box 10631

Jackson, Mississippi 39209

WATER WELL DRILLERS LOG

JACKSON
N2280

4-14-86

Coast Water Well Svc

Jackson

date well completed

firm name

county well located

LANDOWNER: John Fuller

203 Hosli Rd.

Biloxi, Miss.
(mailing address)

WELL LOCATION:

sec. 12 T. 7 N. R. 9 E.
2 miles NORTH of Ocean Springs
(distance) (direction) (nearest town)

WELL PURPOSE:

(home, irrigation, municipal, industrial)

WELL COMPLETION DATA:

- (1) diameter (inches) 2"
- (2) total depth (feet) 462'
- (3) static water level (feet) 70' below top of ground.
- (4) casing PVC 437' (material) (depth)
2" (size) if telescope see back.
- (5) screen 20' 437' (length) (depth to top)
2" (size) PVC (material)
- (6) pump 1/2 HP 6 (HP) (yield gpm)
Electric (type power)
- (7) electric log no (yes or no)

(organization running log)

- (8) how well bottom plugged backwash valve

DRILLERS REMARKS:

5' - 2" PVC tail pipe

description of formations encountered

from

to


Top Soil	0	2
Blue Clay	2	85
White Coarse sand	85	97
Blue Clay	97	257
Blue Clay + streak of sand	257	262
Blue Clay	262	370
Blue Clay + streak of sand	370	400
Gray Coarse sand	400	457
Blue Clay	457	462
	437	20
	457	

RECEIVED
MAY 12 1986

Department of Natural Resources
Bureau of Land & Water Resources

If well telescopes please sketch and show depths.

GROUND LEVEL

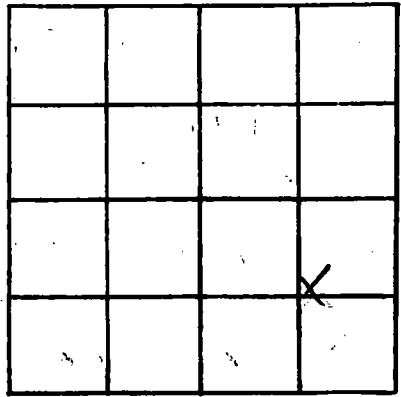

SECTION 12

Please indicate well location X.

ADDITIONAL INFORMATION

If more than one screen, show locations of each on sketch.