

MISSISSIPPI DEPARTMENT OF NATURAL RESOURCES

Bureau of Land and Water Resources

Southport Mall

P.O. Box 10631

Jackson, Mississippi 39209

WATER WELL DRILLERS LOG

JACKSON  
N 2281

5-5-86 19 Coast Water Well Svc Jackson  
date well completed firm name county well located

LANDOWNER: James O. Little

3905 Queen Elizabeth Dr.

Ocean Springs MS

(mailing address) 39564

description of formations encountered

from

to

Top Soil	0	1
White Coarse Sand	1	8
Blue Clay	8	44
White Coarse Sand	44	45
Blue Clay	45	70
Fine Gray Sand	70	75
Blue Clay	75	95
med Gray Sand	95	115
Blue Clay	115	120

WELL LOCATION:

sec 12 T 7 N R 8 E  
S W  
IN miles (distance) direction of (nearest town) Ocean Springs

WELL PURPOSE: Irrigation  
(home, irrigation, municipal, industrial)

WELL COMPLETION DATA:

- (1) diameter (inches) 2"
- (2) total depth (feet) 120'
- (3) static water level (feet) 45' below top of ground.
- (4) casing (material) PVC (depth) 105'
- (size) 2" if telescope see back.
- (5) screen (length) 10' (depth to top) 105'
- (size) 2" (material) PVC
- (6) pump (HP) (yield gpm)
- (type power)
- (7) electric log no (yes or no)
- (organization running log)

(8) how well bottom plugged backwash valve

DRILLERS REMARKS:

5' - 2" PVC tail pipe


RECEIVED

JUL 18 1986

Department of Natural Resources  
Bureau of Land & Water Resources

If well telescopes please sketch and show depths.

GROUND LEVEL

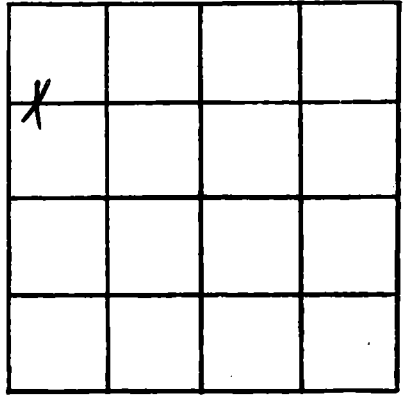

SECTION 22

Please indicate well location X.

ADDITIONAL INFORMATION

If more than one screen, show locations of each on sketch.