

MISSISSIPPI DEPARTMENT OF NATURAL RESOURCES
Bureau of Land and Water Resources
 Southport Mall
 P.O. Box 10631
 Jackson, Mississippi 39209
WATER WELL DRILLERS LOG

JACKSON
N 2282

5-9-86 19 Coast water well Jackson
 date well completed firm name county well located

LANDOWNER: Mitch Parker
PO Box 1432
Biloxi ms 39533
 (mailing address)

WELL LOCATION:
 sec 23 T 7 R 8
1/2 miles NE of OCEAN SPRINGS
 (distance) (direction) (nearest town)

WELL PURPOSE: home
 (home, irrigation, municipal, industrial)

WELL COMPLETION DATA:

(1) diameter (inches) 2"

(2) total depth (feet) 484'

(3) static water level (feet) 69' below top of ground

(4) casing PVC 459'
 (material) (depth)

2" if telescope see back.
 (size)

(5) screen 20' 459'
 (length) (depth to top)

2" PVC
 (size) (material)

(6) pump 1hp 6
 (HP) (yield gpm)


elect.
 (type power)

(7) electric log no
 (yes or no)

(organization running log)

(8) how well bottom plugged backwash valve


description of formations encountered	from	to
Top Soil	0	2
Red Clay	2	11
Blue Clay	11	47
Blue Clay + Streak of Sand	47	81
Gray Coarse Sand	81	90
Blue Clay	90	220
Blue Fine sand	220	274
Blue Clay + streak of Sand	274	320
Blue Fine sand	320	346
Blue Clay + Oyster shell	346	387
Blue Clay	387	430
Blue Clay + streak of sand	430	450
Gray Coarse Sand	450	484
Blue Clay	484	

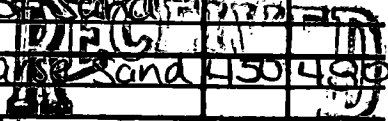
 MISSISSIPPI DEPARTMENT OF NATURAL RESOURCES
 Bureau of Land and Water Resources
 477

DRILLERS REMARKS:
5' - 2" PVC tail pipe

If well telescopes please sketch and show depths.

GROUND LEVEL

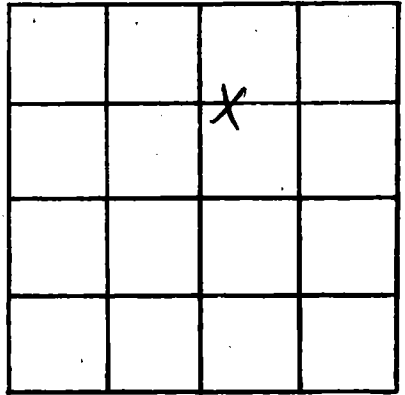

SECTION 23

Please indicate well location X.

ADDITIONAL INFORMATION

If more than one screen, show locations of each on sketch.