

MISSISSIPPI DEPARTMENT OF NATURAL RESOURCES

Bureau of Land and Water Resources

Southport Mall

P.O. Box 10631

Jackson, Mississippi 39209

WATER WELL DRILLERS LOG

JACKSON
N 2284

5-29-86 19 Coast water well Jackson
date well completed firm name county well located

LANDOWNER: MRO JACOB
9116 Ocean Springs
Ocean Springs mo
(mailing address)

description of formations encountered	from	to
Top soil	0	2
White coarse sand	2	6

WELL LOCATION:
sec. 23 T. 7 N R. 8 E
1/2 miles NE of OCEAN SPRINGS
(distance) (direction) (nearest town)

Blue Clay	6	35
White coarse sand	35	45

WELL PURPOSE: HOYD
(home, irrigation, municipal, industrial)

Blue Clay	45	64
-----------	----	----

WELL COMPLETION DATA:

- (1) diameter (inches) 2"
- (2) total depth (feet) 510'
- (3) static water level (feet) 62' ^{below} _{above} top of ground.
- (4) casing PVC 485'
(material) (depth)
2" (size) if telescope see back.
- (5) screen 20' 485'
(length) (depth to top)
2" (size) PVC (material)
- (6) pump 1 (HP) 7 1/2 (yield gpm)
Eled (type power)
- (7) electric log no (yes or no)
(organization running log)
- (8) how well bottom plugged backwash valve

Gray med sand	64	130
Blue Clay w streaks of sand	130	133
Blue Clay	133	430
Gray med sand	430	510


RECEIVED
JUL 18 1986

Department of Natural Resources
Bureau of Land & Water Resources

DRILLERS REMARKS:
5' - 2" PVC
tail pipe.

If well telescopes please sketch and show depths.

GROUND LEVEL

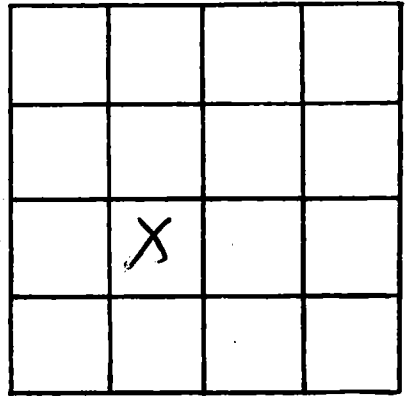

SECTION 23

Please indicate well location X.

ADDITIONAL INFORMATION

If more than one screen, show locations of each on sketch.