

MISSISSIPPI DEPARTMENT OF NATURAL RESOURCES

Bureau of Land and Water Resources

Southport Mall

P.O. Box 10631

Jackson, Mississippi 39209

WATER WELL DRILLERS LOG

Jackson
N 9286

6-3-86 19 Coast water well Jackson
date well completed firm name county well located

LANDOWNER	Description of formations encountered	from	to
Charlie Randa			
12920 Hanover Dr	Top. Soil	0	1
Ocean Springs mo (mailing address) 39564	White Coarse Sand	1	11
WELL LOCATION: sec. 18 T. 7 N. R. 8 E. 1 miles (distance) N of Ocean Springs (nearest town)	Blue Clay w/ streak of sand	11	45
WELL PURPOSE: Office, Bldg. (home, irrigation, municipal, industrial)	White Coarse Sand	45	55
WELL COMPLETION DATA:	Blue Clay	55	60
(1) diameter (inches) 2"			
(2) total depth (feet) 60'			
(3) static water level (feet) 26' below top of ground.			
(4) casing PRC, 45' (material), (depth)			
2" (size) if telescope see back.			
(5) screen 10', 45' (length), (depth to top)			
2" (size), PRC (material)			
(6) pump 1/2 (HP), 6 (yield gpm)			
Elect (type power)			
(7) electric log NO (yes or no)			
(organization running log)			
(8) how well bottom plugged			

well 55

RECEIVED


AUG 2 1986

DRILLERS REMARKS:
51-5' PRC
tail pipe

Department of Natural Resources
Bureau of Land and Water Resources

If well telescopes please
sketch and show depths.

GROUND LEVEL

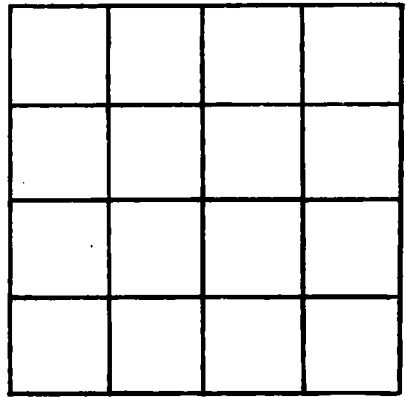

SECTION _____

Please indicate well location X.

ADDITIONAL INFORMATION

If more than one screen,
show locations of each on sketch.