

**MISSISSIPPI DEPARTMENT OF NATURAL RESOURCES**  
**Bureau of Land and Water Resources**  
 Southport Mall  
 P.O. Box 10631  
 Jackson, Mississippi 39209  
**WATER WELL DRILLERS LOG**

Jackson  
N 2287

6-9-86 19 Goodwaterwell Jackson  
 date well completed firm name county well located

**LANDOWNER:** Robert Krome  
PO Box 6 8908  
Ocean Springs  
 (mailing address) MO.

**WELL LOCATION:**  
 sec. 23 T. 7 N R. 8 W  
1 miles (distance) NE (direction) of Ocean Springs (nearest town)

**WELL PURPOSE:** home  
 (home, irrigation, municipal, industrial)

**WELL COMPLETION DATA:**

(1) diameter (inches) 2"

(2) total depth (feet) 515'

(3) static water level (feet) 68' below top of ground

(4) casing PVC 400'  
 (material) (depth)  
2" if telescope see back.  
 (size)

(5) screen 20' 490'  
 (length) (depth to top)  
2" PVC  
 (size) (material)

(6) pump 1 8  
 (HP) (yield gpm)  
Elect  
 (type power)

(7) electric log NO  
 (yes or no)  
 (organization running log)

(8) how well bottom plugged backwash valve

description of formations encountered	from	to
<u>top soil</u>	<u>0</u>	<u>2</u>
<u>Red Clay</u>	<u>2</u>	<u>20</u>
<u>Blue Clay</u>	<u>20</u>	<u>84</u>
<u>gray sand</u>	<u>84</u>	<u>100</u>
<u>Blue Clay</u>	<u>100</u>	<u>224</u>
<u>Blue fine sand</u>	<u>224</u>	<u>274</u>
<u>Blue Clay + oyster shells</u>	<u>274</u>	<u>446</u>
<u>Gray medium sand</u>	<u>446</u>	<u>457</u>
<u>Blue Clay</u>	<u>457</u>	<u>470</u>
<u>Gray sand</u>	<u>470</u>	<u>510</u>
<u>Gray sand + gravel</u>	<u>510</u>	<u>515</u>

490  
22  
**RECEIVED**


AUG 20 1986

Department of Natural Resources  
 Bureau of Land & Water Resources

**DRILLERS REMARKS:**  
5'-2" PVC tailpipe

If well telescopes please sketch and show depths.

GROUND LEVEL

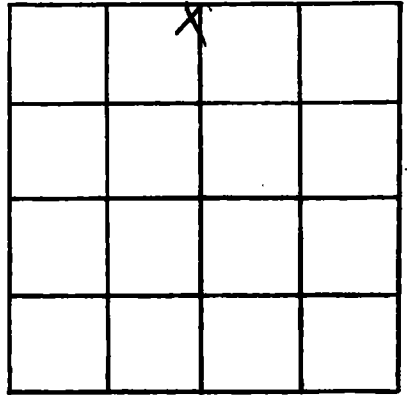

SECTION 23

Please indicate well location X.

ADDITIONAL INFORMATION

If more than one screen, show locations of each on sketch.