

MISSISSIPPI DEPARTMENT OF NATURAL RESOURCES

Bureau of Land and Water Resources

Southport Mall

P.O. Box 10631

Jackson, Mississippi 39209

WATER WELL DRILLERS LOG

Jackson  
N 2288

6-12-86 19 Coast water well Jackson  
date well completed firm name county well located

LANDOWNER: Rufus Battise  
8016 Cook Rd.  
North Biloxi, MS  
(mailing address) 39532

WELL LOCATION:  
sec. 10 T. 7 N R. 9 W  
1 miles NORTH of D'BERVILLE  
(distance) (direction) (nearest town)

WELL PURPOSE:  
(home, irrigation, municipal, industrial)

WELL COMPLETION DATA:  
(1) diameter (inches) 2"  
(2) total depth (feet) 431'  
(3) static water level (feet) 75' below top of ground  
(4) casing PUC 416' (material), (depth)  
2" (size) if telescope see back.  
(5) screen 10' 416' (length), (depth to top)  
2" PUC (size) (material)  
(6) pump 1 (HP), 6 (yield gpm)  
Elect. (type power)  
(7) electric log no (yes or no)  
(organization running log)  
(8) how well bottom plugged backwash valve

description of formations encountered	from to	
top soil	0	3
Red Clay	3	11
Blue Clay	11	19
White Coarse Sand + wood	19	51
Blue Clay + streaks of sand	51	102
Gray Coarse Sand	102	175
Blue Clay	175	235
Blue Fine Sand	235	253
Blue Clay	253	314
Blue Clay + Outer shell	314	328
Blue Clay	328	390
Gray Coarse Sand	390	426
Blue Clay	426	431


416' 10' 426' 431'  
RECEIVED  
AUG 20 1986

DRILLERS REMARKS:  
5'-2" PUC tail pipe

Department of Natural Resources  
Bureau of Land & Water Resources

If well telescopes please sketch and show depths.

GROUND LEVEL

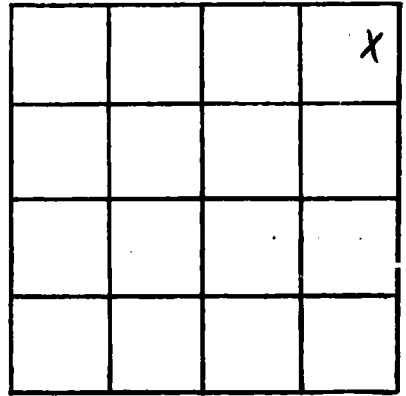

SECTION 10

Please indicate well location X.

ADDITIONAL INFORMATION

If more than one screen, show locations of each on sketch.