

MISSISSIPPI DEPARTMENT OF NATURAL RESOURCES
Bureau of Land and Water Resources
 Southport Mall
 P.O. Box 10631
 Jackson, Mississippi 39209
WATER WELL DRILLERS LOG

JACKSON
N 2291

July 1, 1986 19 Coast water well Jackson
 date well completed firm name county well located

LANDOWNER: Dr. Dees
1501 Kensington
Ocean Springs ms
 (mailing address)

WELL LOCATION:
 sec. 29 T. 7 N. R. 8 E
IN miles → of Ocean Springs
 (distance) (direction) (nearest town)

WELL PURPOSE: Irrigation
 (home, irrigation, municipal, industrial)

WELL COMPLETION DATA:

- (1) diameter (inches) 2"
- (2) total depth (feet) 150'
- (3) static water level (feet) 25 ^{below} above top of ground.
- (4) casing PVC, 135',
 (material) (depth)
2" If telescope see back.
 (size)
- (5) screen 10', 135'
 (length) (depth to top)
2" PVC
 (size) (material)
- (6) pump _____
 (HP) (yield gpm)

 (type power)
- (7) electric log no
 (yes or no)

 (organization running log)
- (8) how well bottom plugged backwash valve

description of formations encountered	from	to
<u>Top Soil</u>	<u>0</u>	<u>2</u>
<u>Brown Clay</u>	<u>2</u>	<u>4</u>
<u>White Coarse Sand</u>	<u>4</u>	<u>14</u>
<u>Blue Clay</u>	<u>14</u>	<u>89</u>
<u>Gray Fine Sand</u>	<u>89</u>	<u>105</u>
<u>Blue Clay</u>	<u>105</u>	<u>121</u>
<u>White Coarse Sand</u>	<u>121</u>	<u>145</u>
<u>Blue Clay</u>	<u>145</u>	<u>150</u>
<u>135</u>		
<u>10</u>		
<u>well 145</u>		


RECEIVED
 AUG 28 1986

Department of Natural Resources
 Bureau of Land & Water Resources

DRILLERS REMARKS:
5' - 2" PVC tail pipe

If well telescopes please sketch and show depths.

GROUND LEVEL

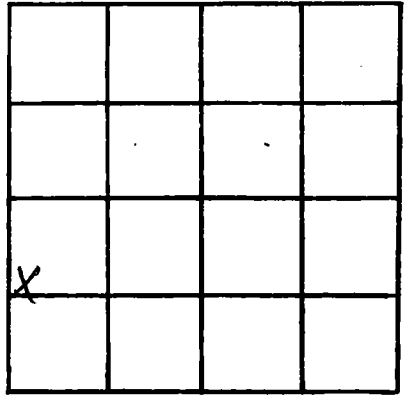

SECTION 29

Please indicate well location X.

ADDITIONAL INFORMATION

If more than one screen,
show locations of each on sketch.