

MISSISSIPPI DEPARTMENT OF NATURAL RESOURCES

Bureau of Land and Water Resources

Southport Mall

P.O. Box 10631

Jackson, Mississippi 39209

WATER WELL DRILLERS LOG

Jackson  
N 2296

8-8-86  
date well completed

19 Coast water well Jackson  
firm name county well located

LANDOWNER: Chester Beauford

105 Ashley Place  
Ocean Springs, MS  
(mailing address)

WELL LOCATION:

sec. 32 T 7 N R 8 E  
1 1/2 miles SE of Ocean Springs  
(distance) (direction) (nearest town)

WELL PURPOSE: Irrigation  
(home, irrigation, municipal, industrial)

WELL COMPLETION DATA:

- (1) diameter (inches) 2"
- (2) total depth (feet) 130ft.
- (3) static water level (feet) 35 below ground top of ground.
- (4) casing PVC, 115' (depth)  
2" (size) If telescope see back.
- (5) screen 10' (length), 115' (depth to top)  
2" (size), PVC (material)
- (6) pump 1hp (HP), 9 (yield gpm)  
elect. (type power)
- (7) electric log NO (yes or no)  
(organization running log)

(8) how well bottom plugged, backwash valve

DRILLERS REMARKS:

5' - 2" PVC tailpipe

Description of formations encountered

from to

|                   |     |     |
|-------------------|-----|-----|
| Top Soil          | 0   | 1   |
| White Coarse sand | 1   | 18  |
| Blue Clay         | 18  | 52  |
| White Coarse sand | 52  | 70  |
| Blue Clay         | 70  | 90  |
| White Coarse sand | 90  | 125 |
| Fine sand         | 125 | 130 |


RECEIVED

SEP 11 1986

Department of Natural Resources  
Bureau of Land & Water Resources

If well telescopes please sketch and show depths.

GROUND LEVEL

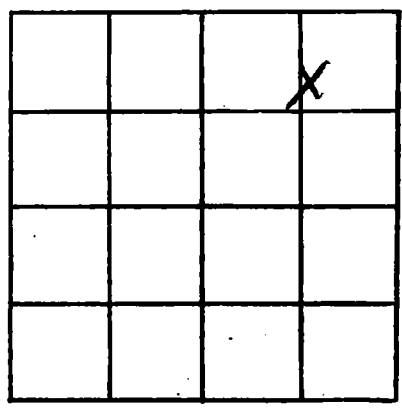

SECTION 32.

Please indicate well location X.

ADDITIONAL INFORMATION

Lined area for additional information.

If more than one screen, show locations of each on sketch.