

MISSISSIPPI DEPARTMENT OF NATURAL RESOURCES

Bureau of Land and Water Resources

P.O. Box 10631

Jackson, Mississippi 39209

WATER WELL DRILLERS LOG

COUNTY WELL LOCATED	
JACKSON	
WELL NUMBER	CODED
N 2310	
DATE WELL COMPLETED	
10-29-86	

PERMIT NUMBER
NAME OF DRILLING FIRM
Coast water well

NAME & MAILING ADDRESS OF LANDOWNER			
Greg Baggett			
1202 Telephone Rd			
Pascagoula ms			
WELL LOCATION:	SEC	TOWNSHIP	RANGE
	33	7	8
		N	E
DISTANCE	DIRECTION	NEAREST TOWN	
1/2	SE	Springs	
Miles of			
OTHER LANDMARK			
WELL PURPOSE: Home, Irrigation, Municipal, Industrial, Fish Pond, etc.			
home			

PUMP DATA		
PUMP TYPE (Circle One):		
Submersible,	Turbine,	Jet
Other (Describe)		Flowing Well.
POWER TYPE (Circle One):		
Electric,	Tractor,	Diesel,
Other (Describe)		Gasoline, Butane,
Pump Capacity (GPM)	No. of Stages	Setting Depth
		FT.
PUMP TEST		
Well yielded _____ GPM with		
a drawdown of _____ ft.		
after _____ hours of pumping		

WELL DATA		
Well Depth	Casing Diameter (In.)	Casing Length (Ft.)
530	2"	560'
Type of Casing	Hole Depth	Depth to Static Water Level
PVC	535	56'
TYPE OF COMPLETION: (Circle One or More):		
Gravel Packed,	Underreamed,	Telescoped,
Natural Development,	Open Hole,	Other
(Describe)		
Top of Lap Pipe or Reduction in Casing		
FEET	IF TELESCOPED OR MORE THAN ONE SCREEN: USE BACK PAGE	

LOG DATA	
TYPE OF LOG RUN (Circle One):	
Electric,	No Log Run
Gamma Ray,	Density,
Sonic,	Neutron,
Other (Describe)	
Name of Organization Running Log	

SCREEN DATA		
Diameter - Inches	Length - Feet	Slot Size - Inches
2"	20'	.008
Screen Type	Depth to Bottom - Feet	
PVC	530'	

GEOLOGIC DATA (Office Use Only)			
Surface Elev.	Geologic Unit	Unit Thickness	Depth to Top
Subs. SWL	Date	Analysis	Aquifer Test

Driller's Remarks


RECEIVED

DESCRIPTION OF FORMATIONS ENCOUNTERED	FROM	TO	FORMATIONS (Continued)	FROM	TO
Top Soil	0	10	Blue Clay	314	423
Blue Clay	10	45	Gray Sand	423	442
White Coarse Sand + wood	45	75	Blue Clay	442	500
Blue Clay	75	101	Gray Fine Sand	500	528
White Coarse Sand	101	141	Blue Clay	528	538
Blue Clay + streaked sand	141	150	6" Rock	538	538
Blue Clay	150	246	Gray Med Sand	538	580
4" Rock	246	246	Blue Clay	580	585
Blue Clay	246	289			
Gray Coarse Sand	289	314			

IF MORE SPACE IS NEEDED, USE BACK

If well telescopes please sketch and show depths.

GROUND LEVEL

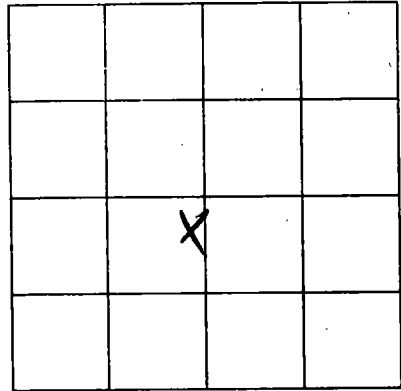

SECTION 33

Please indicate well location X:

ADDITIONAL INFORMATION

If more than one screen,
show location of each on sketch.