

# MISSISSIPPI DEPARTMENT OF NATURAL RESOURCES

Bureau of Land and Water Resources

P.O. Box 10631

Jackson, Mississippi 39209

## WATER WELL DRILLERS LOG

COUNTY WELL LOCATED <b>Jackson</b>	
WELL NUMBER <b>N 2301</b>	CODED
DATE WELL COMPLETED <b>10-31-86</b>	

PERMIT NUMBER
NAME OF DRILLING FIRM <b>Coastwater well</b>

NAME & MAILING ADDRESS OF LANDOWNER <b>Stanley Kopszywa</b>			
<b>237 Myrtle St</b>			
<b>Biloxi, MS</b>			
WELL LOCATION:	SEC	TOWNSHIP	RANGE
	<b>35</b>	<b>7 N</b>	<b>8 E</b>
DISTANCE	DIRECTION	NEAREST TOWN	
<b>1/2</b> Miles	<b>east</b>	<b>Ocean Springs</b>	
OTHER LANDMARK			
WELL PURPOSE: Home, Irrigation, Municipal, Industrial, Fish Pond, etc. <b>home</b>			

PUMP DATA		
PUMP TYPE (Circle One): Submersible, Turbine, <input checked="" type="radio"/> <b>Flowing Well</b> , Other (Describe) _____		
POWER TYPE (Circle One): <input checked="" type="radio"/> <b>Electric</b> , Tractor, Diesel, Gasoline, Butane, Other (Describe) _____		
Pump Capacity (GPM) <b>8</b>	No. of Stages <b>2</b>	Setting Depth <b>—</b> FT.
PUMP TEST		
Well yielded <b>8</b> GPM with a drawdown of _____ ft. after <b>—</b> hours of pumping		

WELL DATA		
Well Depth <b>439'</b>	Casing Diameter (In.) <b>2"</b>	Casing Length (Ft.) <b>414'</b>
Type of Casing <b>PRC</b>	Hole Depth <b>439'</b>	Depth to Static Water Level <b>50'</b>
TYPE OF COMPLETION: (Circle One or More): Gravel Packed, Underreamed, Telescoped, <input checked="" type="radio"/> <b>Natural Development</b> , Open Hole, Other		
Top of Lap Pipe or Reduction in Casing FEET IF TELESCOPED OR MORE THAN ONE SCREEN: USE BACK PAGE		

LOG DATA	
TYPE OF LOG RUN (Circle One): Electric, Gamma Ray, Density, Sonic, Neutron, Other (Describe) _____	
Name of Organization Running Log	

SCREEN DATA		
Diameter - Inches <b>2"</b>	Length - Feet <b>20'</b>	Slot Size - Inches <b>.008</b>
Screen Type <b>PRC</b>	Depth to Bottom - Feet <b>434'</b>	


GEOLOGIC DATA (Office Use Only)			
Surface Elev.	Geologic Unit	Unit Thickness	Depth to Top
Subs. SWL	Date	Analysis	Aquifer Test
Driller's Remarks			

DESCRIPTION OF FORMATIONS ENCOUNTERED	FROM	TO	FORMATION (Continued)	FROM	TO
<b>Top Soil</b>	<b>0</b>	<b>2</b>	<b>Blue Clay</b>	<b>57</b>	<b>76</b>
<b>Blue Clay</b>	<b>2</b>	<b>51</b>	<b>Blue Clay</b>	<b>246</b>	<b>400</b>
<b>White Coarse Sand</b>	<b>51</b>	<b>65</b>	<b>Oyster Shell</b>		
<b>Blue Clay</b>	<b>65</b>	<b>96</b>	<b>Gray Coarse Sand</b>	<b>400</b>	<b>434</b>
<b>Blue Clay + Clam Shell</b>	<b>96</b>	<b>106</b>	<b>Blue Clay</b>	<b>434</b>	<b>439</b>
<b>Gray Coarse Sand</b>	<b>106</b>	<b>125</b>			
<b>Blue Clay</b>	<b>125</b>	<b>141</b>			
<b>Gray Coarse Sand</b>	<b>141</b>	<b>157</b>			

IF MORE SPACE IS NEEDED, USE BACK

If well telescopes please sketch and show depths.

GROUND LEVEL

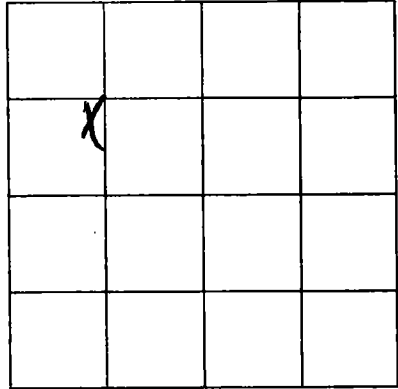

SECTION 35

Please indicate well location X.

ADDITIONAL INFORMATION

If more than one screen, show location of each on sketch.